


# T. 1 N. R. 12 E. W.M.

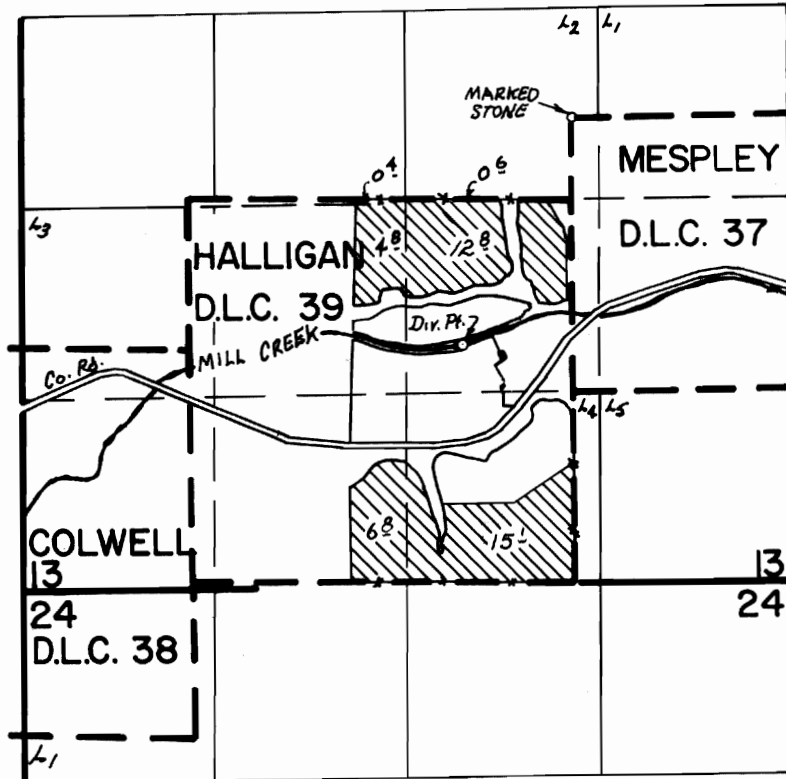

DIV. PT. 10C. 1550' S. & 750' W. FROM THE NW COR MESPLEY D.L.C. 37

## FINAL PROOF SURVEY UNDER

Transfer No. [REDACTED]  
Application No. 59426 Permit No. 44675  
IN NAME OF

KENNETH W. KORTGE

Surveyed Nov. 30, 1983, by T. J. Paul