


T.1S., R.3W., W.M.

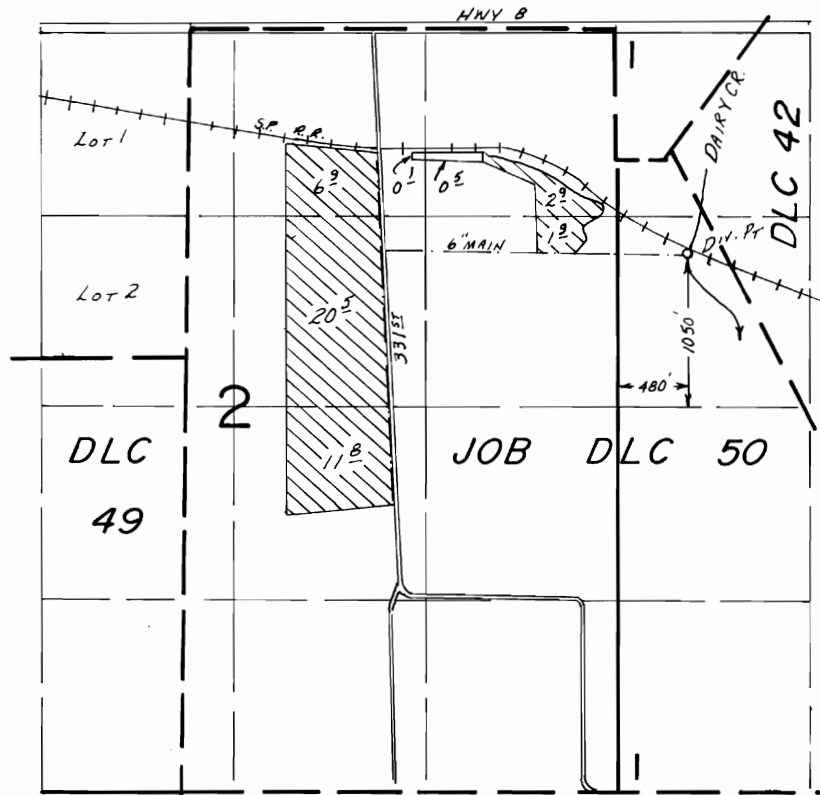

SCALE: 1" = 1320'

FINAL PROOF SURVEY UNDER

TRANSFER No. 4308

IN NAME OF

.....EDMUND DUYCK.....

Surveyed Aug. 23, 19.84, by B.W. BISHOP.....