

T-4309


TOWNSHIP 9 S.

RANGE 40 E.W.M.

RECEIVED

OCT 13 1979

WATER RESOURCES DEPT
SALEM, OREGON

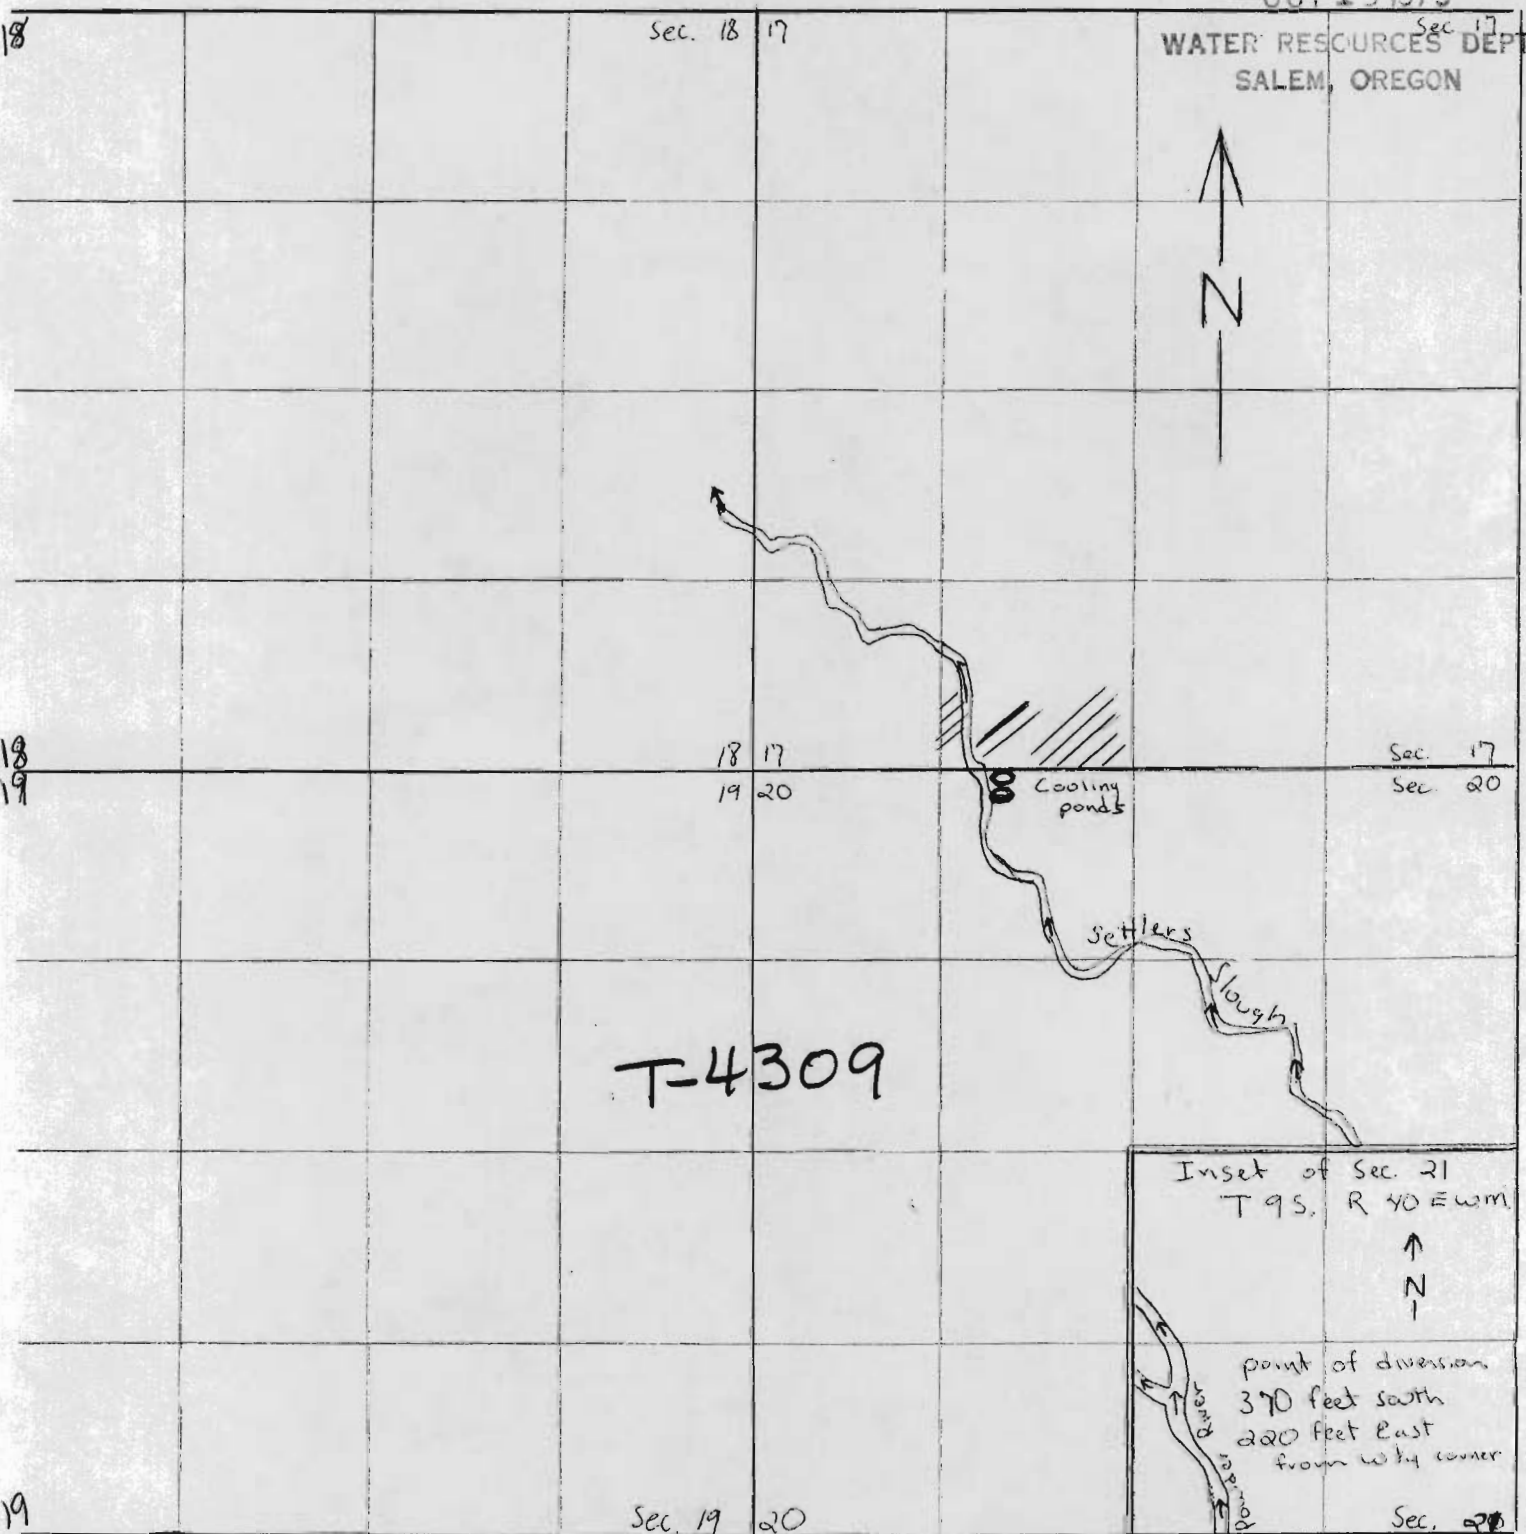

MAP TO ACCOMPANY APPLICATION OF:

Name Ellingson's Lumber Company

County Baker

Date July 10, 1979

Scale 4 inches to 1 Mile

Map for Question 13

Note: Shaded area shows approximate place of use for fire and dust control

MAP PREPARED FROM: Map of Lumber plant and map of city of Baker
SIGNED BY APPLICANT: ELLINGSON LUMBER CO.

MAP DRAWN BY: Floyd C. Vaughan

RECEIVED

JUL 19 1979

WATER RESOURCES DEPT
SALEM, OREGON