


T. 4S., R. 12 & 13E., W. M.

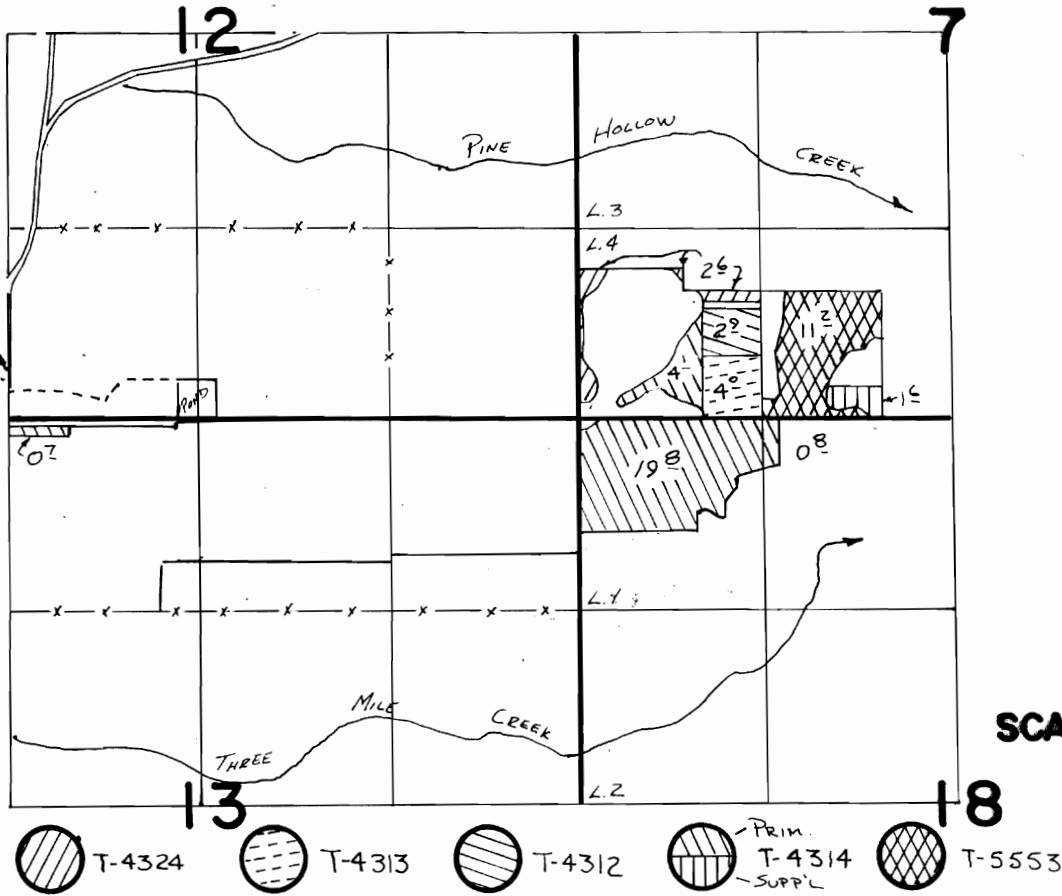


SCALE 1" = 1320'

**FINAL PROOF SURVEY**  
UNDER

**TRANSFERS 4324, 4313, 4312, 4314, 5553**  
IN NAME OF

.....**RAY A. BENZEL**.....


Surveyed 10-18 1988, by V.L. Church.....

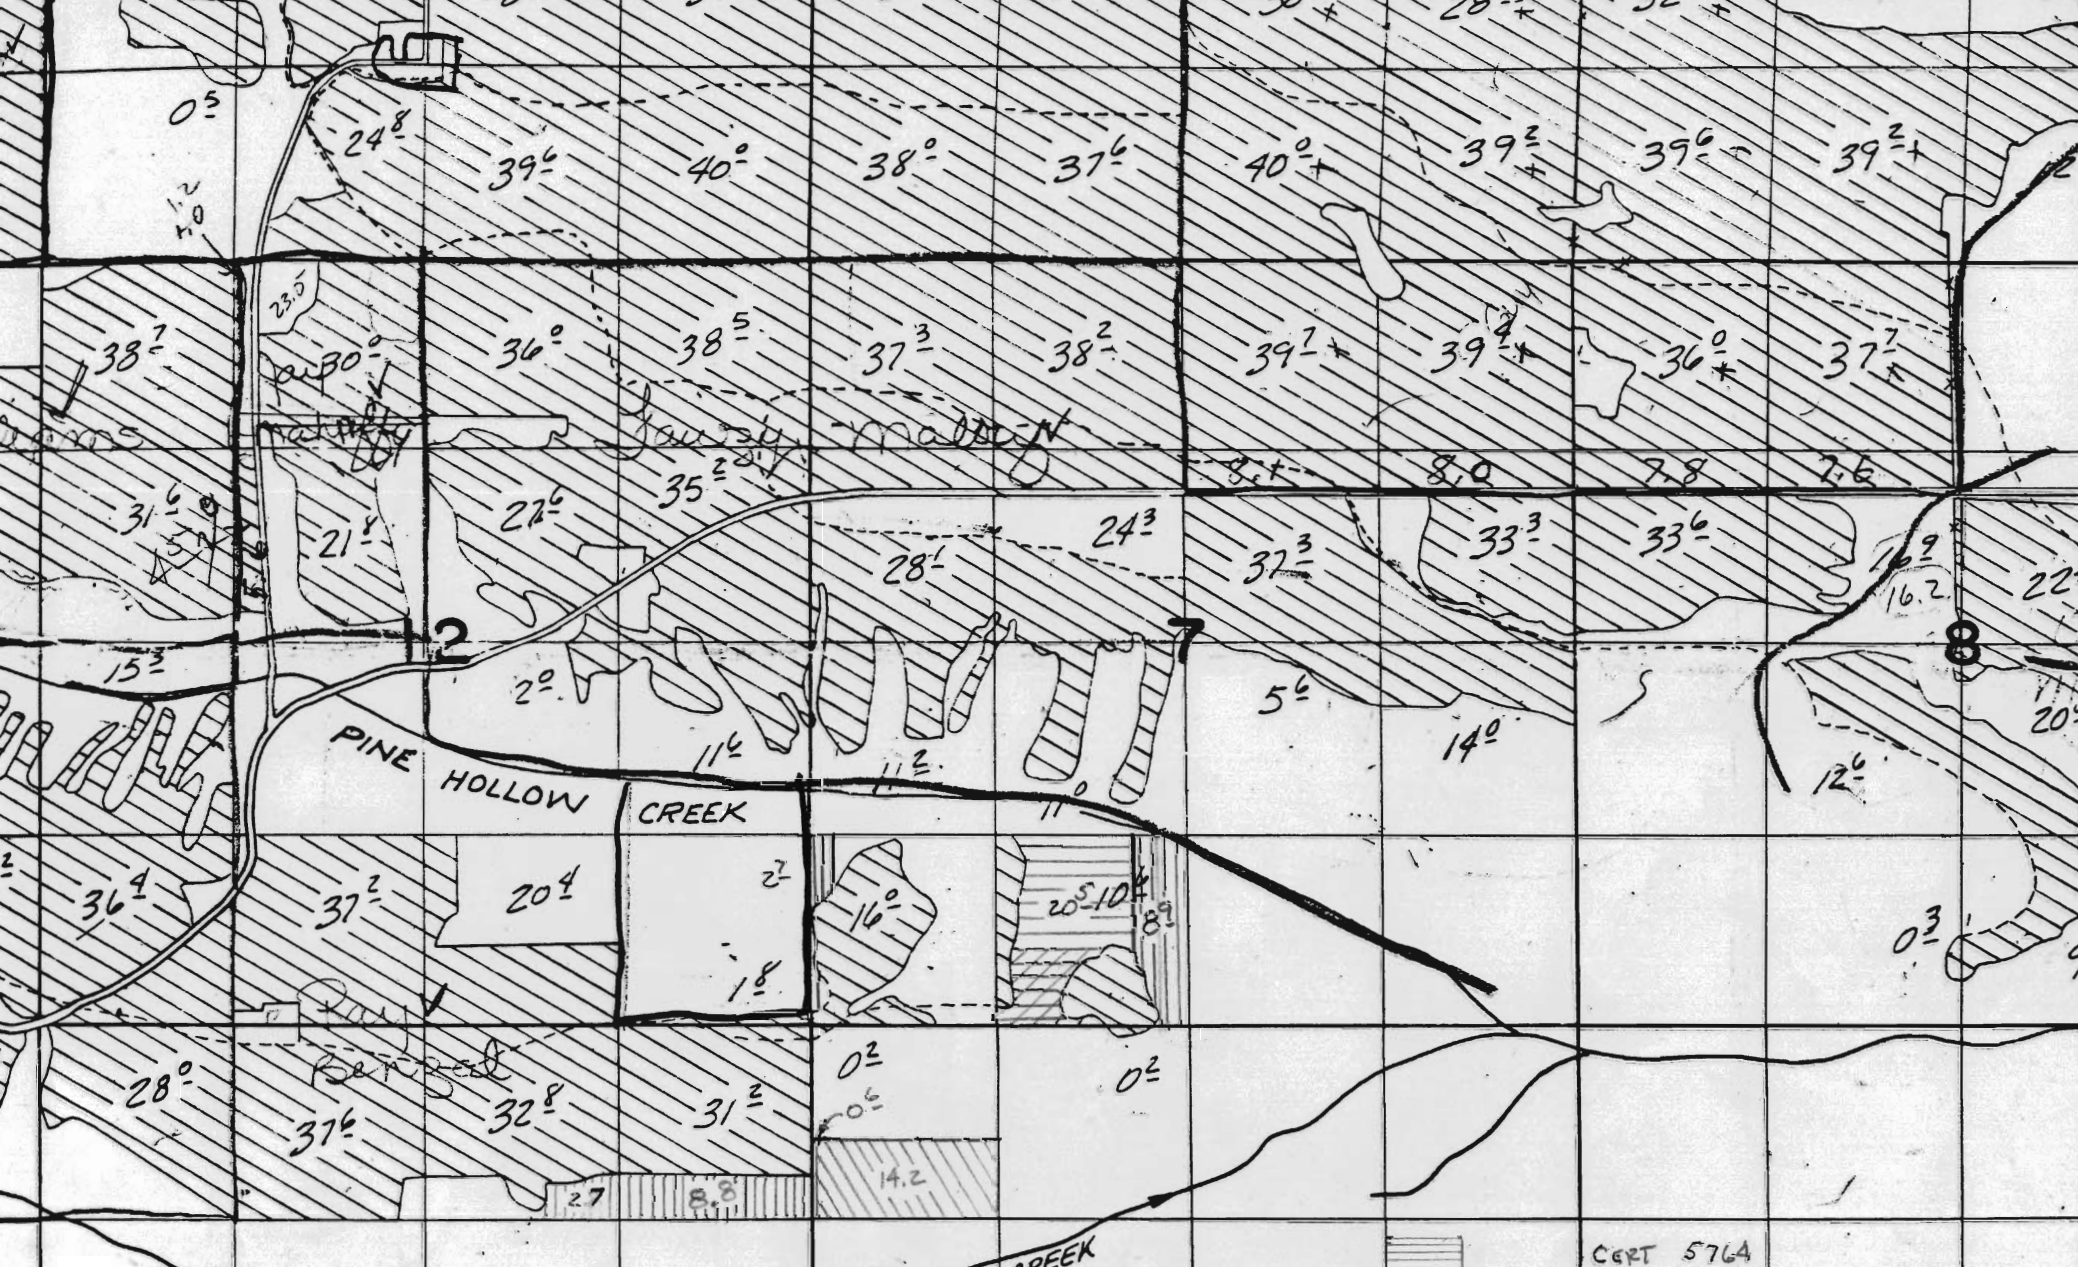

**RECEIVED**

OCT 12 1984

WATER RESOURCES DIVISION  
SALEM, OREGON

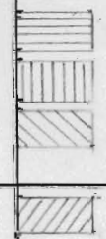

CERT 5764  
PRIMARY CERT 46368  
CERT 46529  
SUPPLEMENTAL CERT 46368

18  
T-5551, 5552,  
5553

17