


T.1N.,R.4W.,W.M.

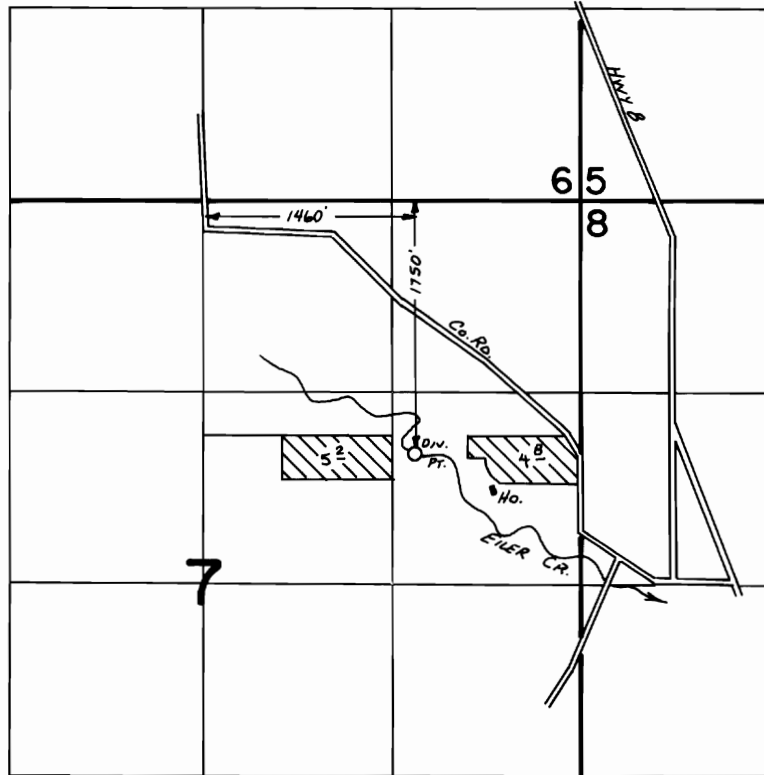

FINAL PROOF SURVEY UNDER

Transfer No. 4327

Application No. Permit No.

IN NAME OF

..... **CARL C. JORGENSEN**

Surveyed ..Nov...1... 19.83., by L. M. TOLL.....