


T. 35 S., R. 7 W., W. M.

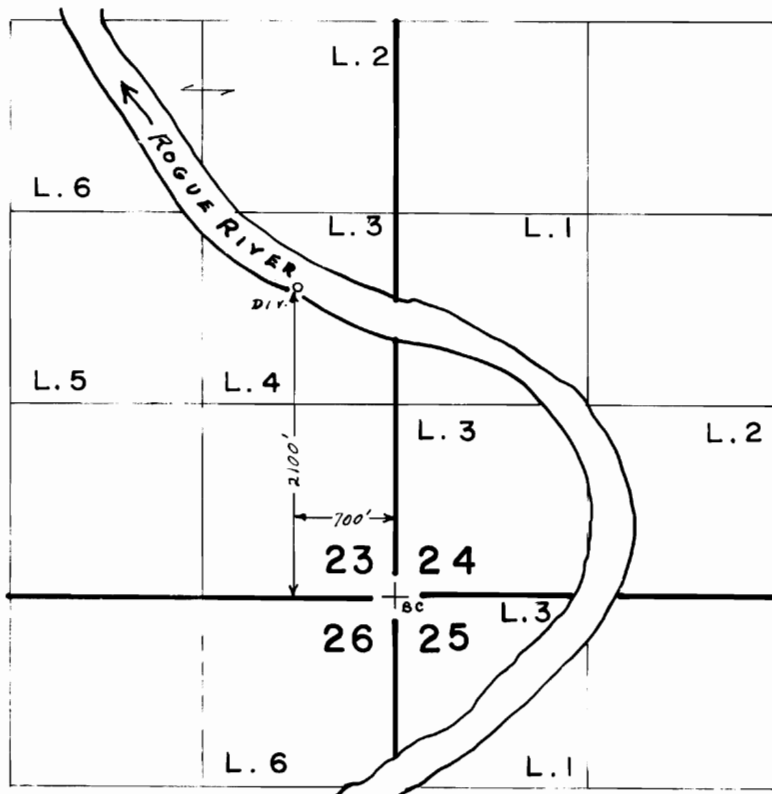

SCALE: 4" = 1 MILE

FINAL PROOF SURVEY

UNDER

TRANSFER 4338

Application No. Permit No.

IN NAME OF

MARTIN G. BAUER

Surveyed O.C.T. 24 1985, by B.S. JAMES...