


T.15S., R.14E., W.M.

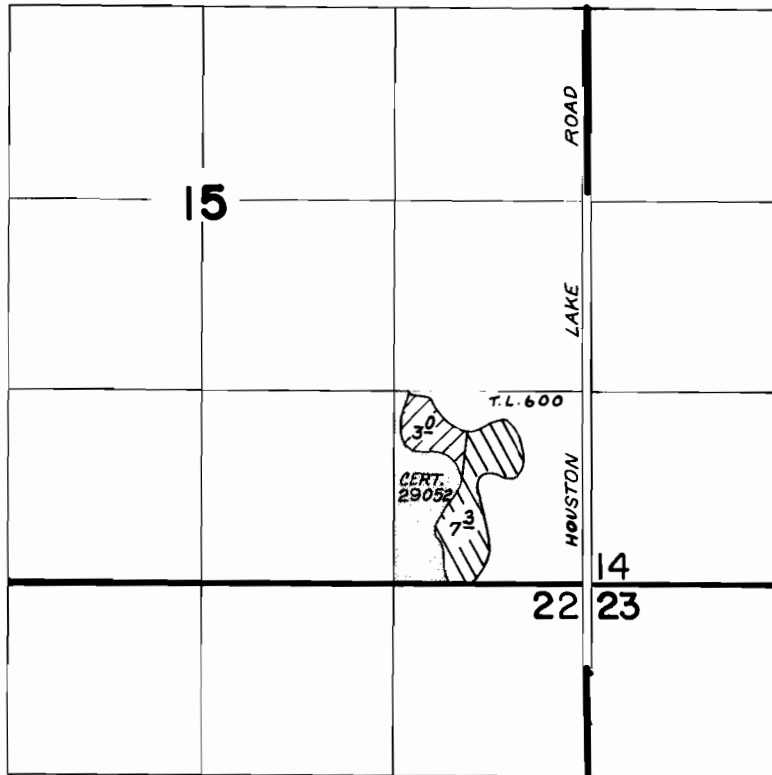

SCALE: 1"=1320'

FINAL PROOF SURVEY UNDER

Transfer 5486 & part of Transfer 2795



IN NAME OF

.....**ERVIN CRABTREE**.....

Surveyed **JULY 2**, 19**85**, by **LESLIE OLSON**...

C.O.D.
v. 24, p. 487
v. 38, p. 580