



T. 6N., R. 35E., W. M.

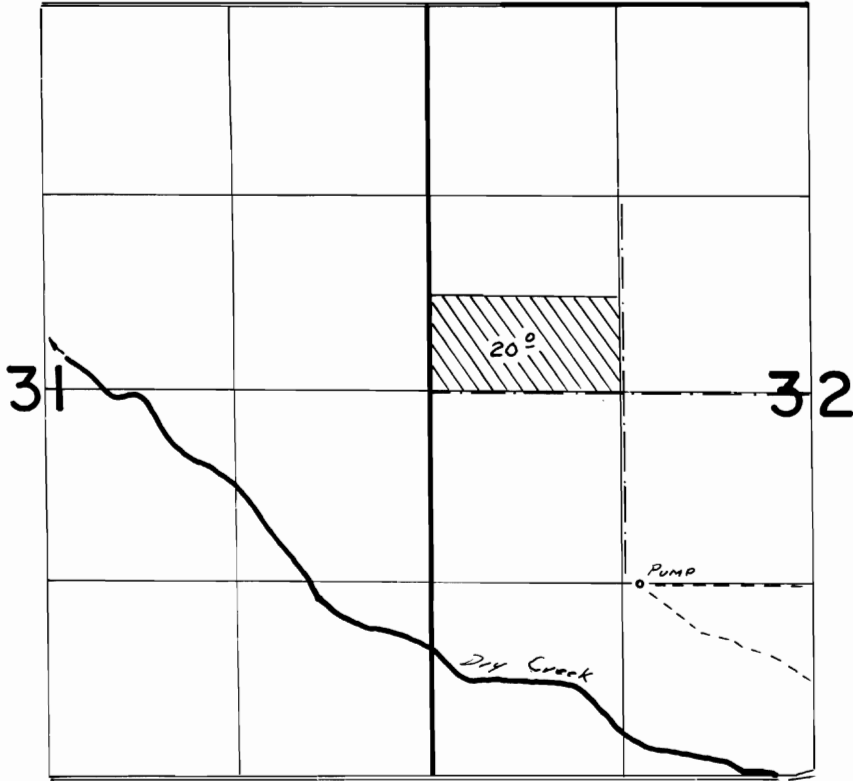

T. 5N., R. 35E., W. M.

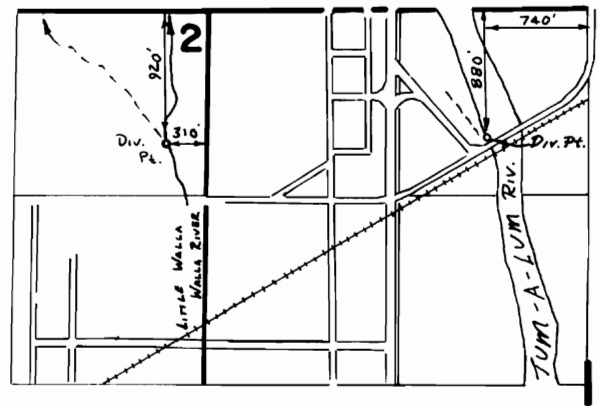

FINAL PROOF SURVEY
UNDER

TRANSFER 4356

IN NAME OF

HERBERT H. HENDRICKS

Surveyed *Nov. 22* 19*83*, by *V. L. Church*