


T. 3N., R. 30E., W. M.

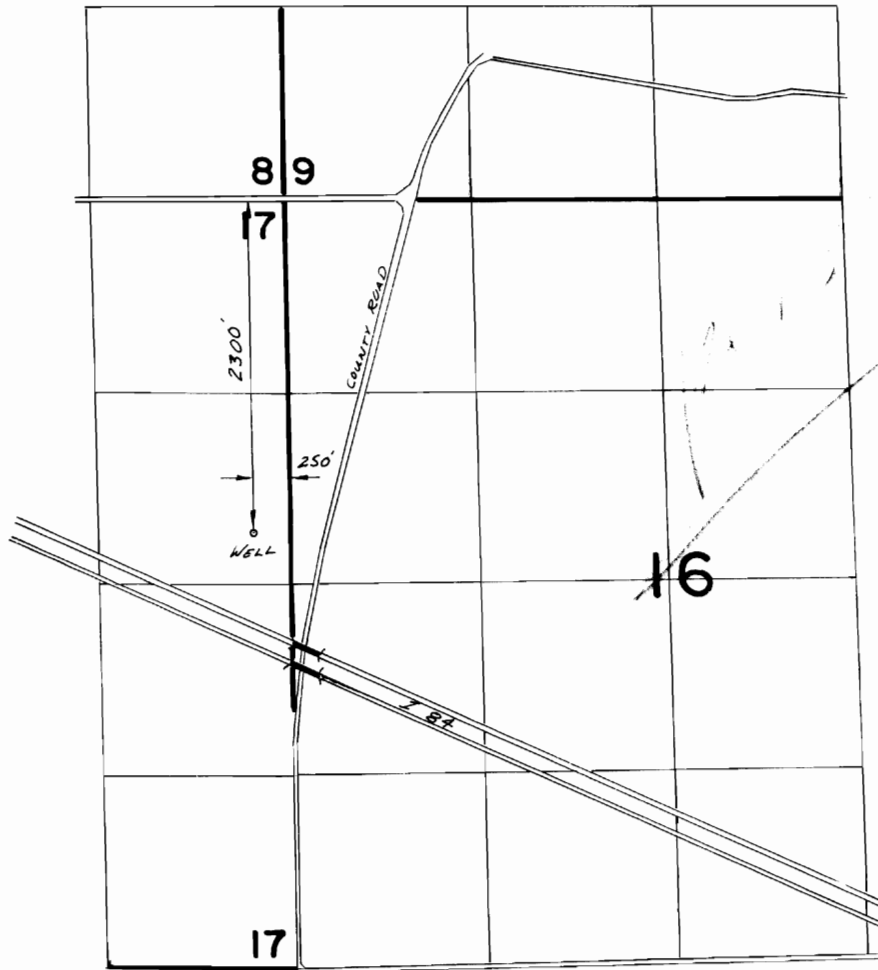

FINAL PROOF SURVEY
UNDER

TRANSFER 4361

IN NAME OF

.....**GLENN L. ROHDE**.....

Surveyed Aug...3..... 1982., by *V. L. Church*.....