


T. 6N., R. 35E., W.M.

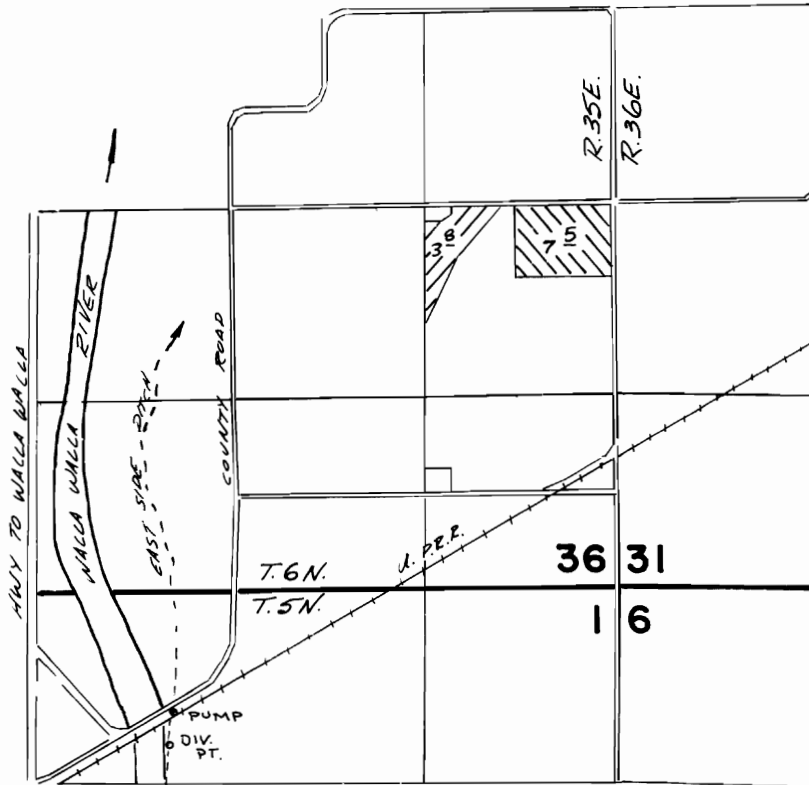

T-4371



T-3854

**FINAL PROOF SURVEY**  
UNDER

**TRANSFER 3854, 4371**

**IN NAME OF**

**SAM C. LeFORE**

Surveyed 3-31 1982, by *Kumar Lee Church*