


T. 6N., R. 35E., W.M.

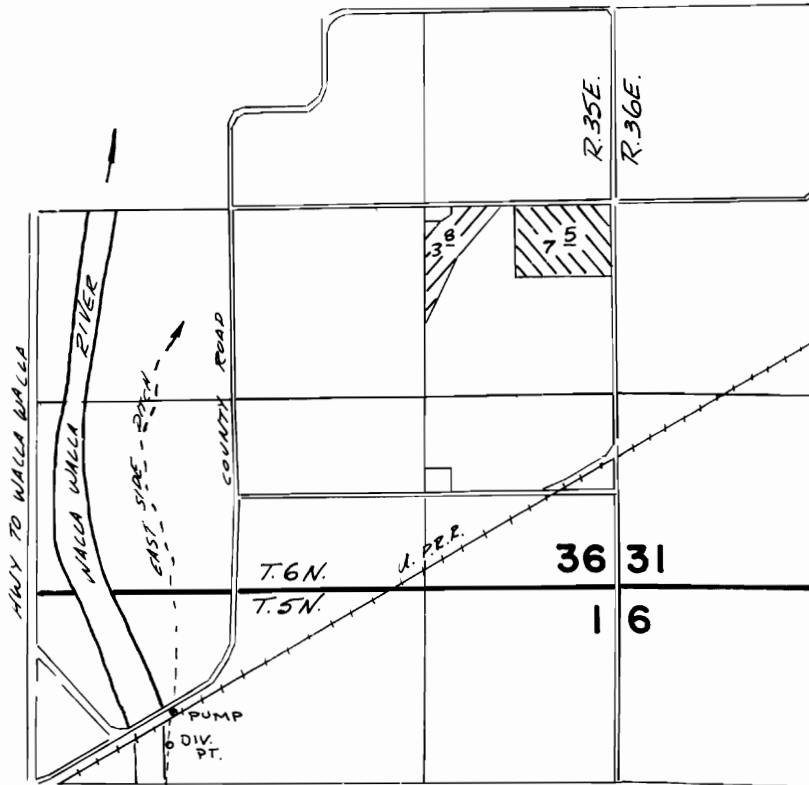

⊗ T-4371

⊗ T-3854

FINAL PROOF SURVEY
UNDER

TRANSFER 3854, 4371

IN NAME OF

SAM C. LeFORE

Surveyed 3-31 1982, by *Kumar Lee Church*