


T. 1 N., R. 4 W., W.M.

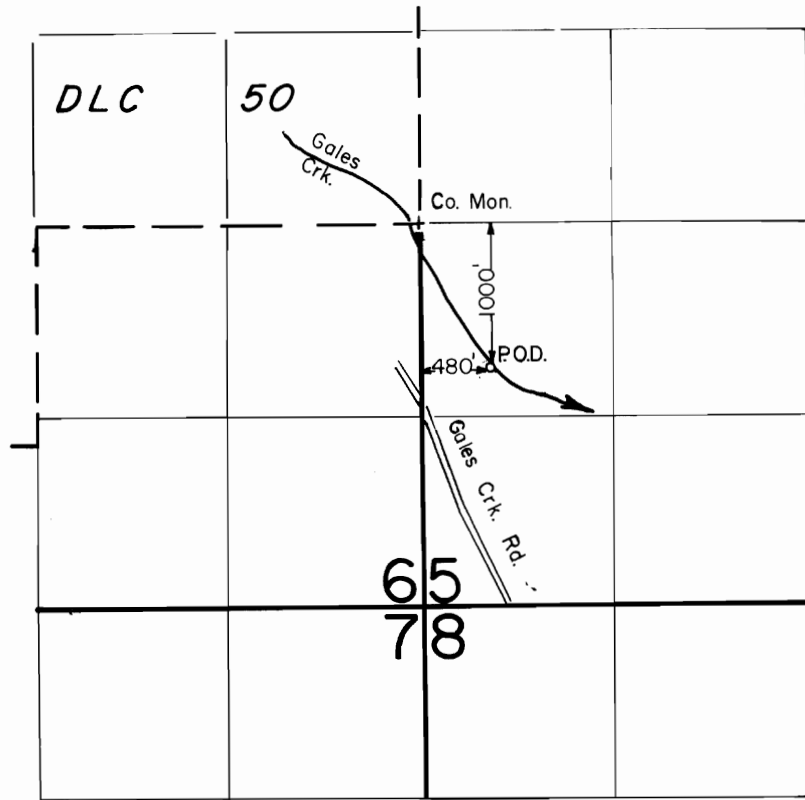

Scale : 1" = 1320'

FINAL PROOF SURVEY UNDER

TRANSFER 4387

Application No. Permit No.
IN NAME OF

ARNOLD COLWELL

Surveyed AUG. 29, 1988, by T. Warren