


T. 7 S. R. 2 W. W.M.

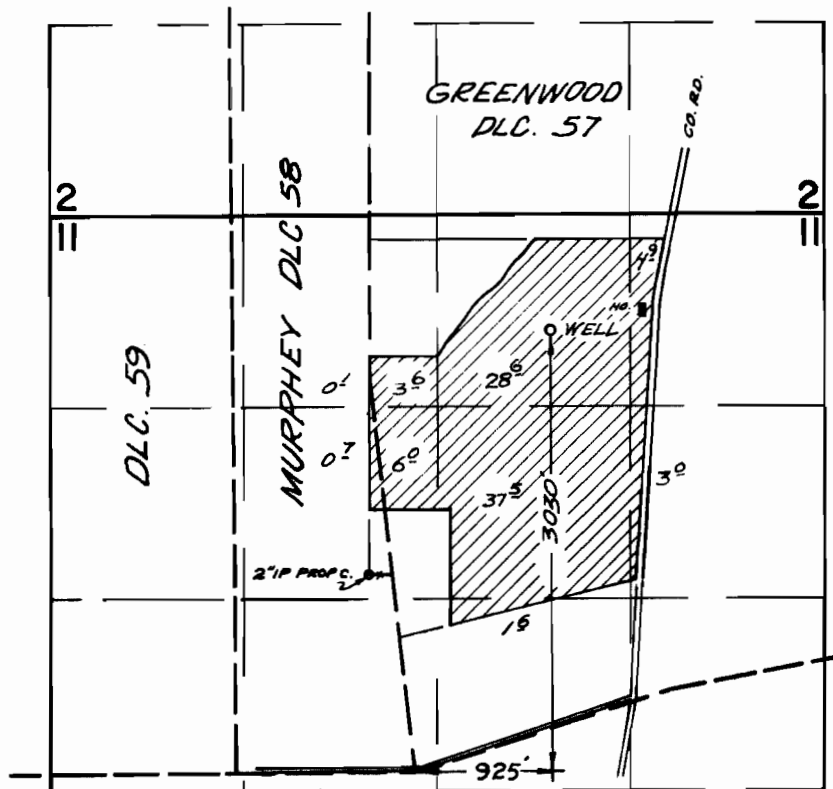

FINAL PROOF SURVEY
UNDER

Application No. G-1758 Permit No. G-1670
IN NAME OF

DANIEL H. ROSS

Surveyed Nov. 20 1967, by V. Garner