


T-4393

RECEIVED
FEB 19 1980
WATER RESOURCES DEPT.
SALEM, OREGON

T 9S R 45E W.M.
SECTION 10

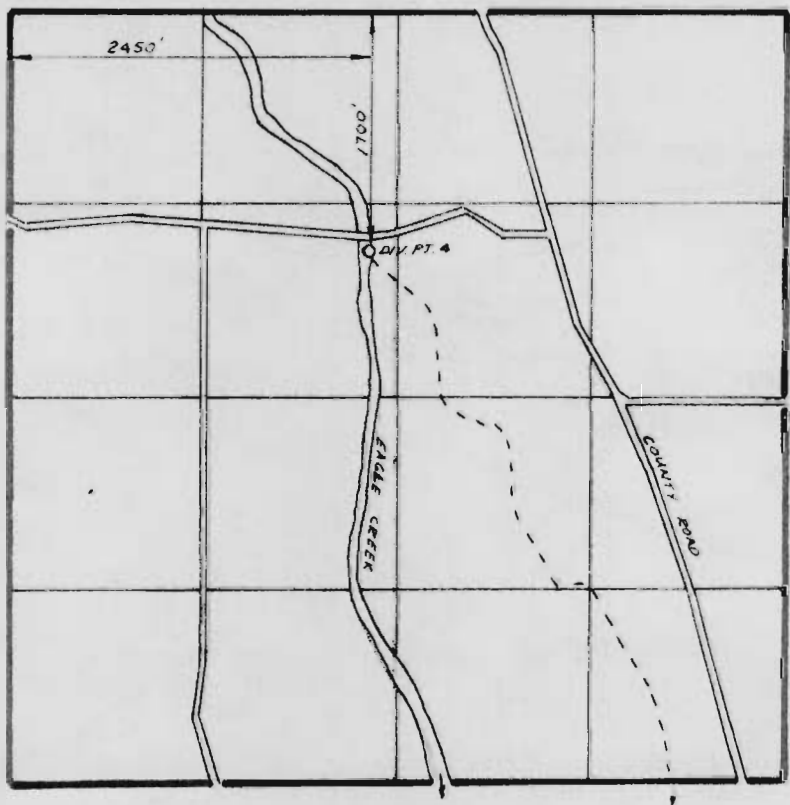


KAY YOUNG DITCH

To

T-4393
RECEIVED

FEB 19 1980
WATER RESOURCES DEPT.
SALEM, OREGON

T 9S R 45E W.M.

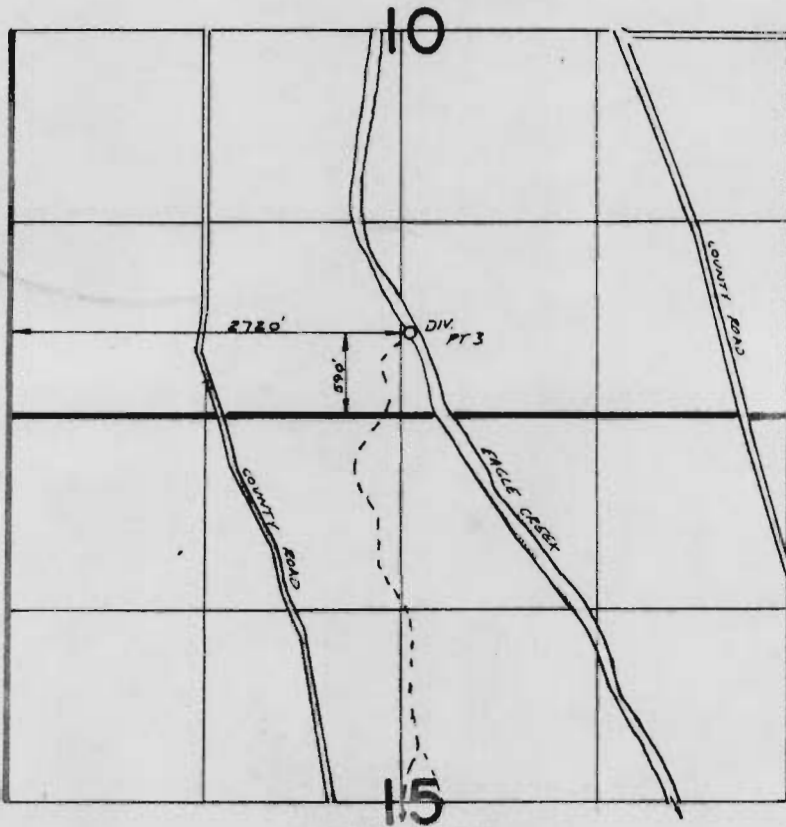

NASH DITCH

From