


T-4394  
RECEIVED  
FEB 10 1980  
WATER RESOURCES DEPT  
SALEM, OREGON

T 9S R 45E W.M.

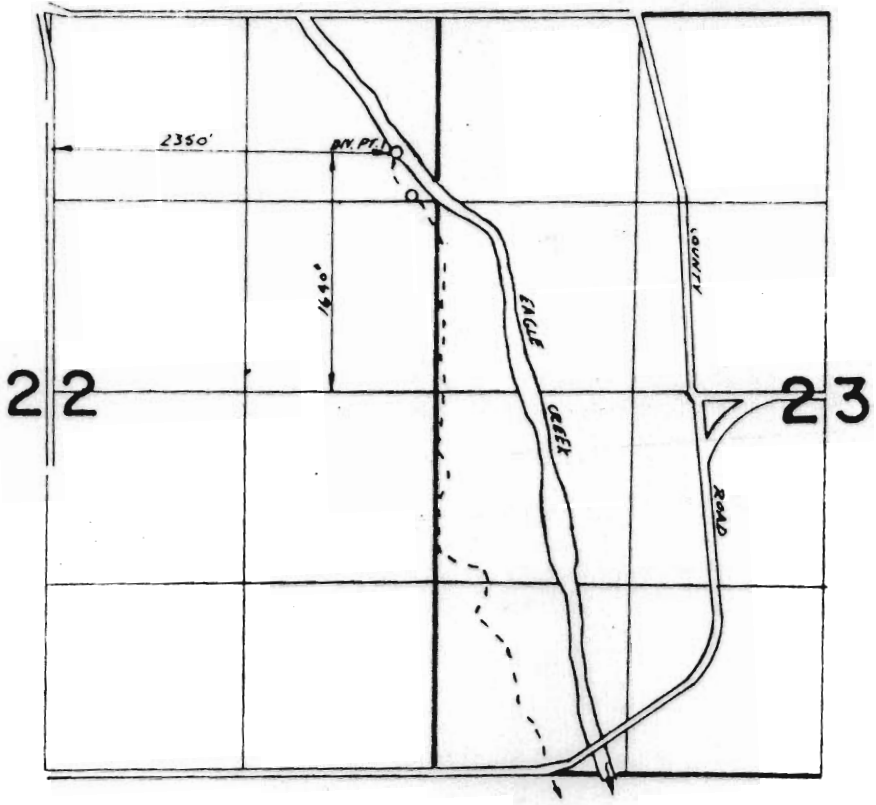

GOVER DITCH  
To