




T.15S., R.14E., W.M.

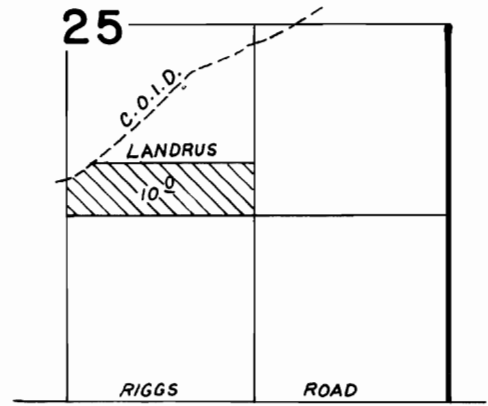

T.14S., R.14E., W.M.

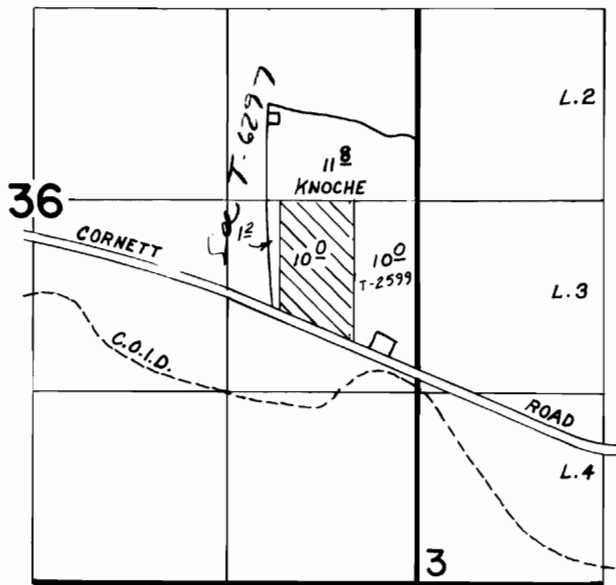

T.14S., R.15E., W.M.

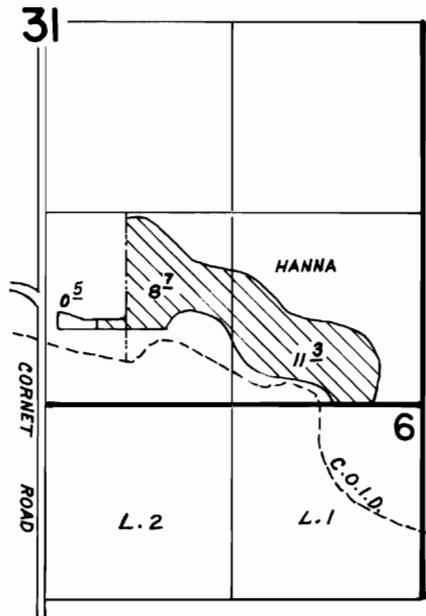

FINAL PROOF SURVEY

UNDER

TRANSFER NO. 4396

Application No. Permit No.

IN NAME OF

KNOCHE; HANNA; LANDRUS; /C.O.I.D.

Surveyed MAY 9 1984, by LESLIE OLSON