


70

T-4405

RECEIVED
FEB 25 1980
WATER RESOURCES DEPT
SALEM, OREGON

T 9S R 45E W.M.
SECTION 15

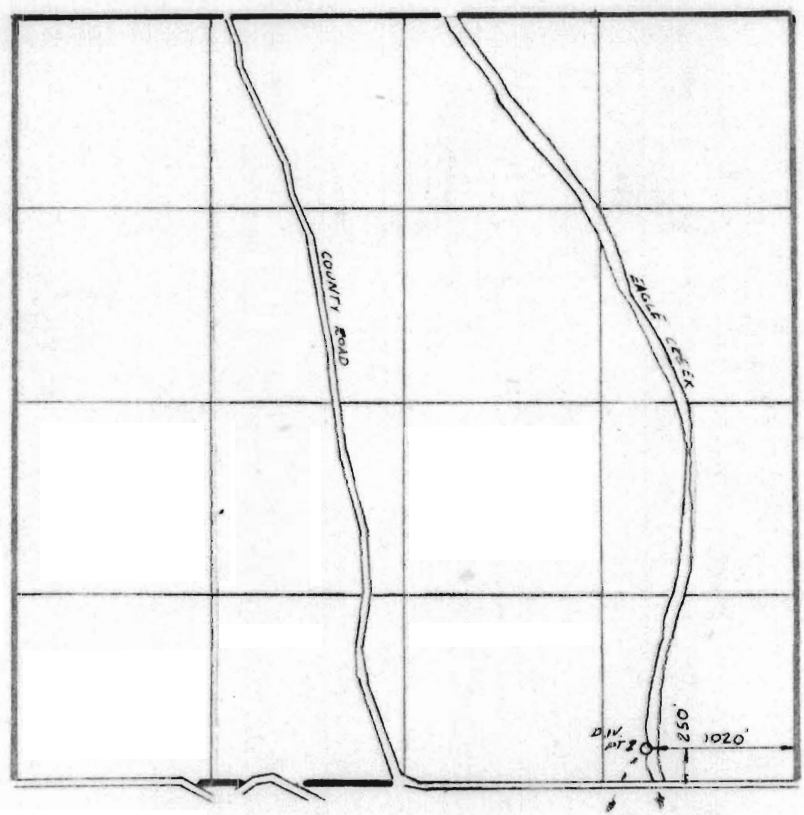

LITTLE EAGLE DITCH