


T. 5N., R. 35E., W.M.

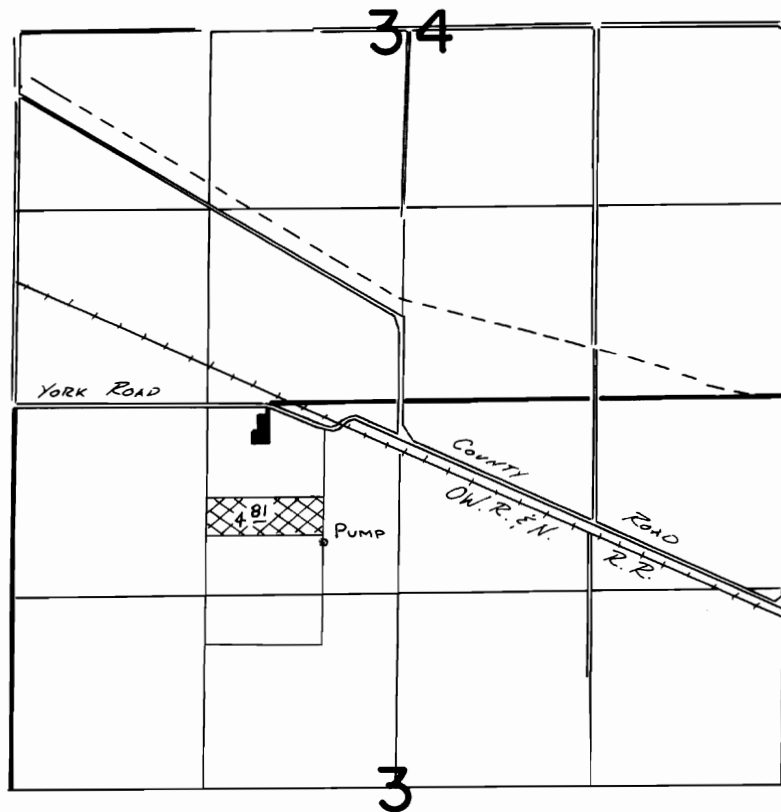

FINAL PROOF SURVEY
UNDER

TRANSFER 4408

IN NAME OF

LEE STEPHENS

Surveyed Aug. 31, 1982, by V.L. CHURCH