


T. 39 S., R. 7 W., W. M.

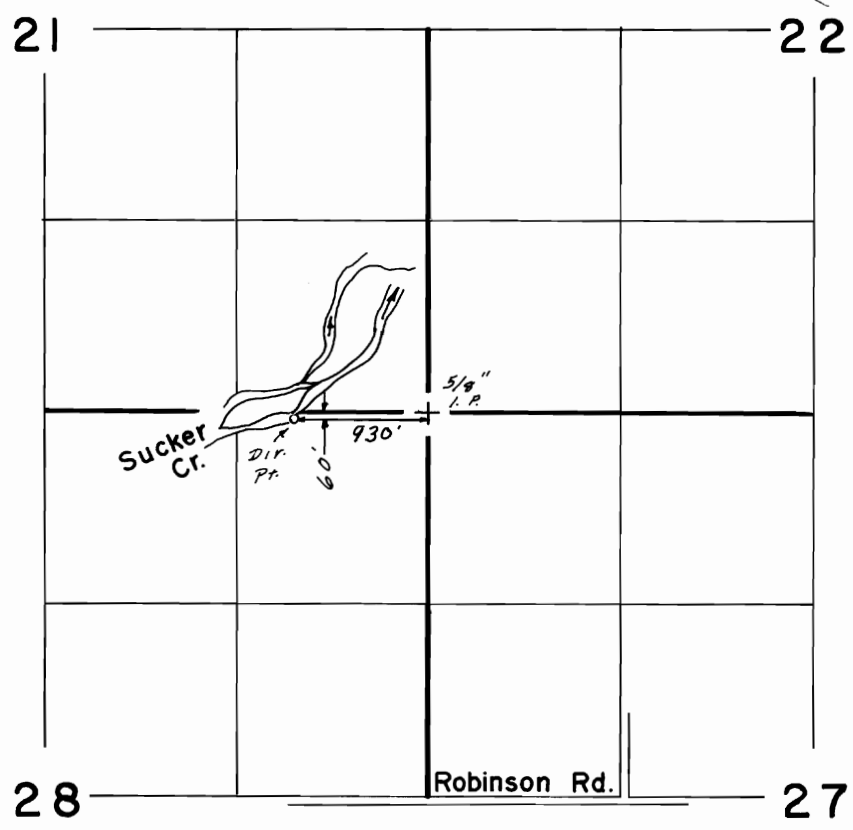

Scale: 1" = 1320'

FINAL PROOF SURVEY UNDER

TRANSFER NO. 4417

Application No. Permit No.
IN NAME OF

.....EUGENE.....LA.....FORCE.....

Surveyed MAY 14 1986, by B. S. JAMES.