


T.37S. R.5W. W.M. .

T.38S. R.4&5 W. W.M.

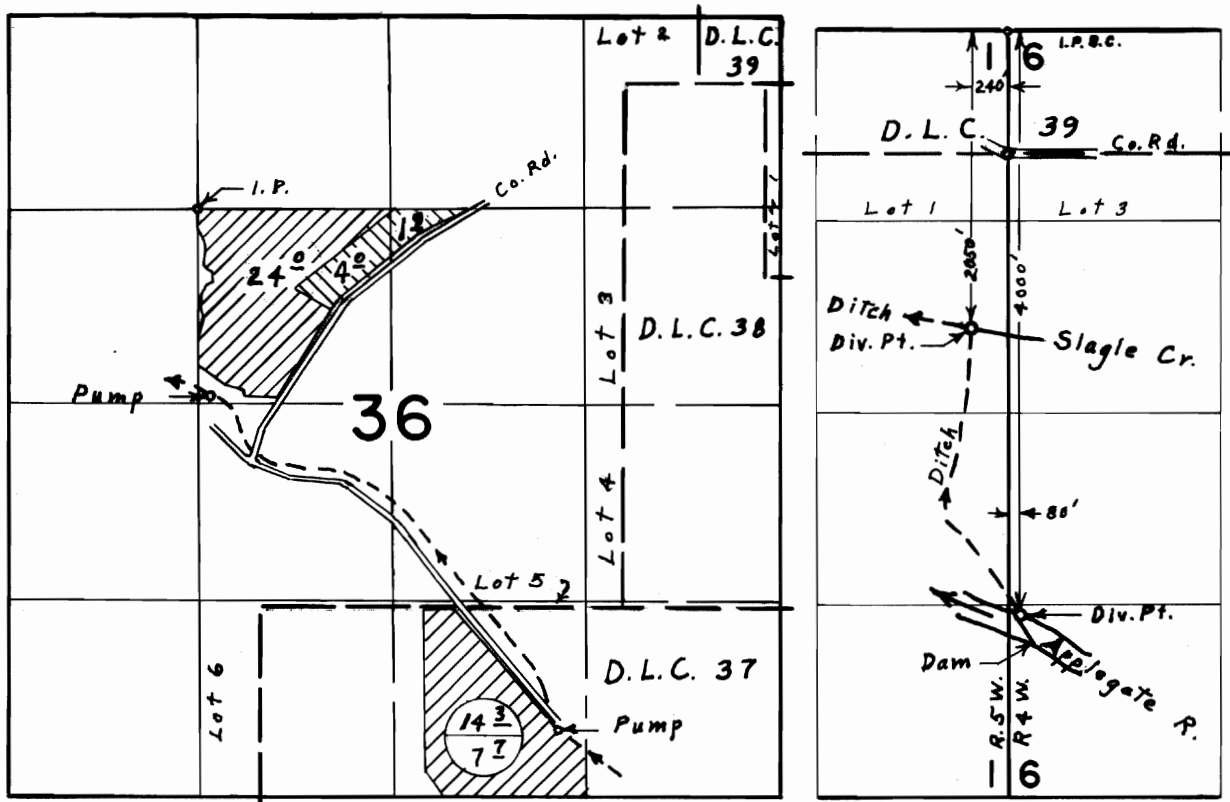

Primary
Supplemental



FINAL PROOF SURVEY
UNDER

Application No. 42776 Permit No. 31281
IN NAME OF

NORTH SIDE APPLGATE RIVER DITCH CO., INC.

Surveyed ^{May 16 1975} ~~Sept. 16 1974~~, by Larry M. Toll