


T-4439

To :

RECEIVED
MAR 24 1980
WATER RESOURCES DEPT
SALEM, OREGON

T 8S R 45E W.M.

SECTION 33

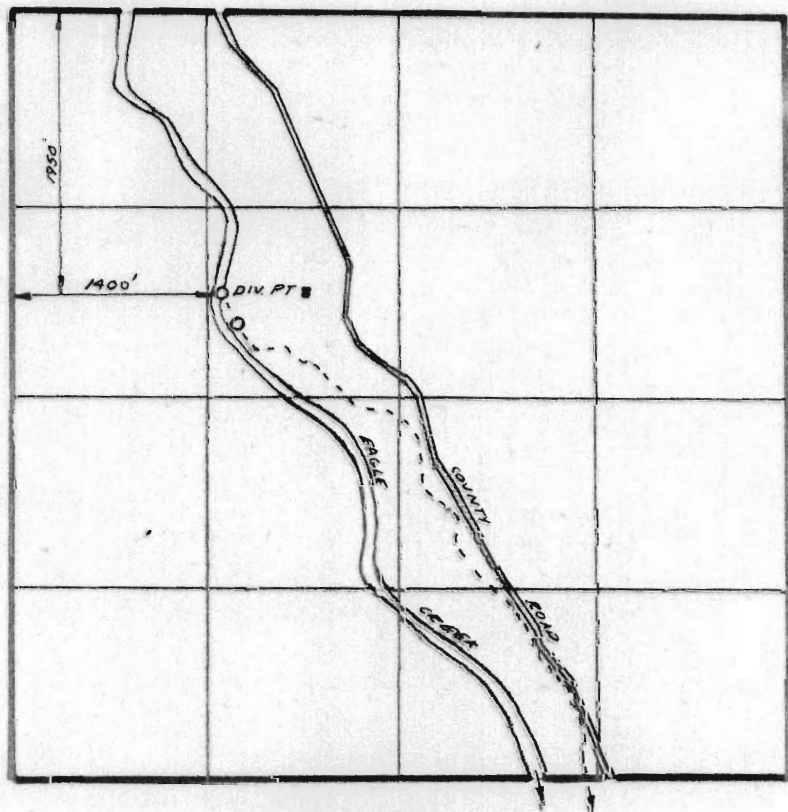

NEW YOUNG DITCH