


T-4444

TO:

T 9S R 45E W.M.
SECTION 10

RECEIVED
MAY 21 1980
WATER RESOURCES DEPT
SALEM, OREGON

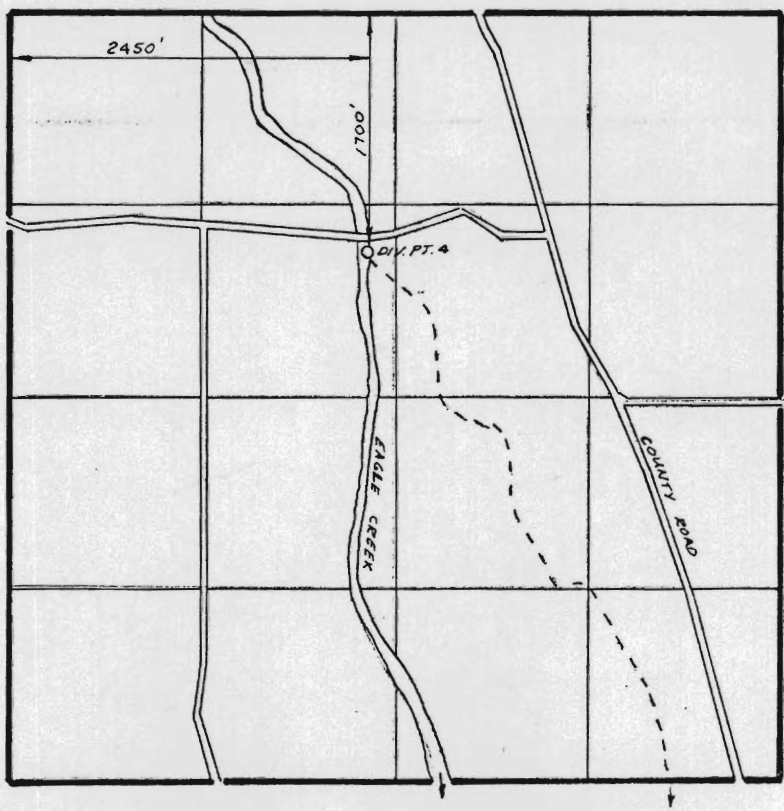

KAY YOUNG DITCH


T4444

FROM:

RECEIVED
MAR 24 1980
WATER RESOURCES DEPT
SALEM, OREGON

T 8S R 45E W.M.

SECTION 33

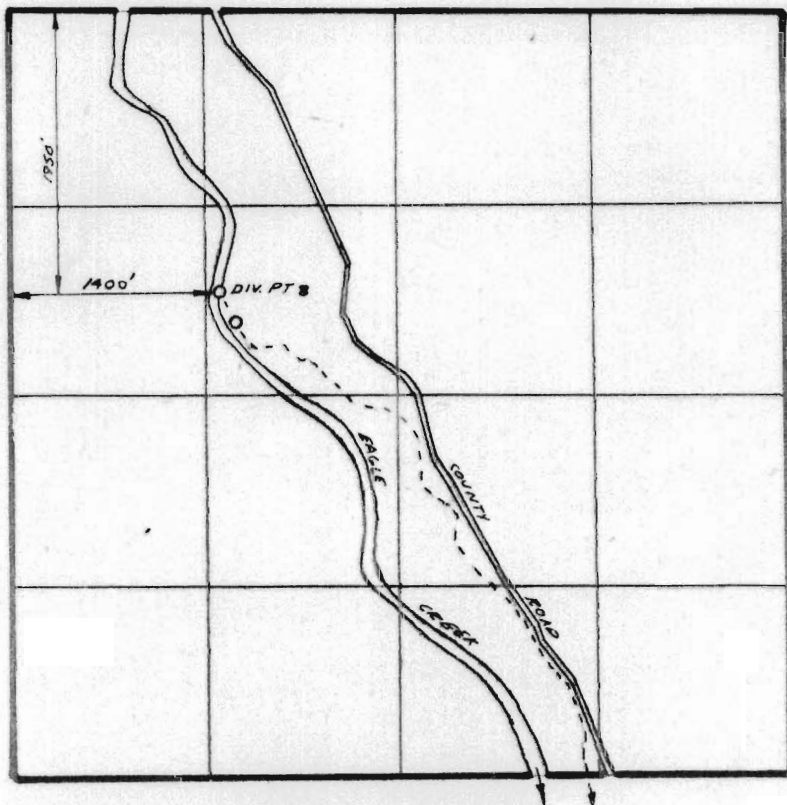

NEWT YOUNG DITCH