


T-4452 TO

T 8S R 45E W.M.
SECTION 33

RECEIVED
MAR 21 1980
WATER RESOURCES DEPT
SALEM, OREGON

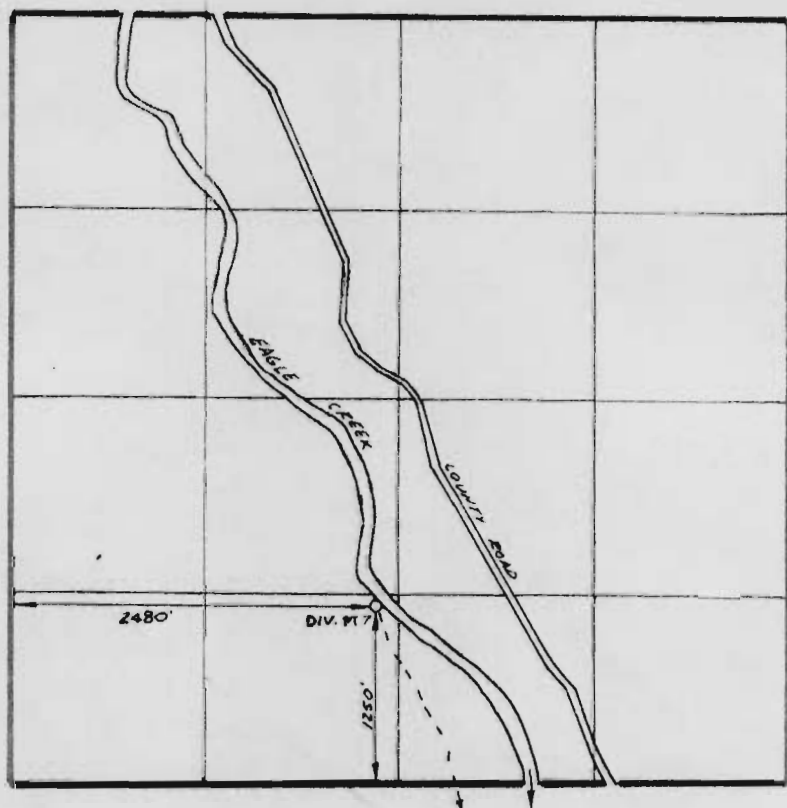

WATERBURY DITCH


T-4452

FROM

RECEIVED
MAR 2 1980
WATER RESOURCES DEPT
SALMON, OREGON

T 8S R 45E W.M.

SECTION 33

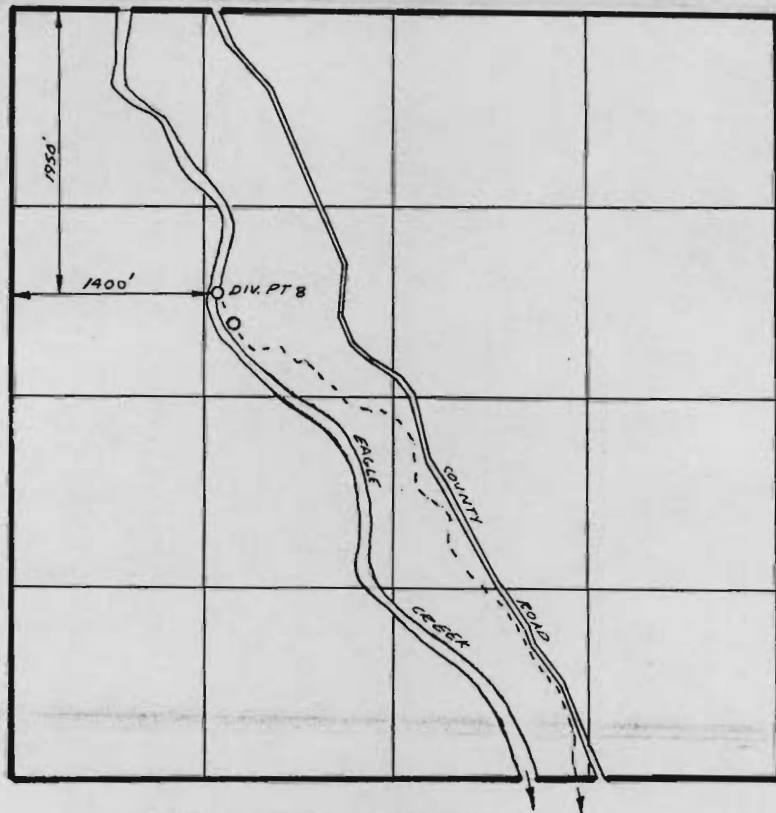

NEWT YOUNG DITCH