


# T.12S.R.6W.W.M.

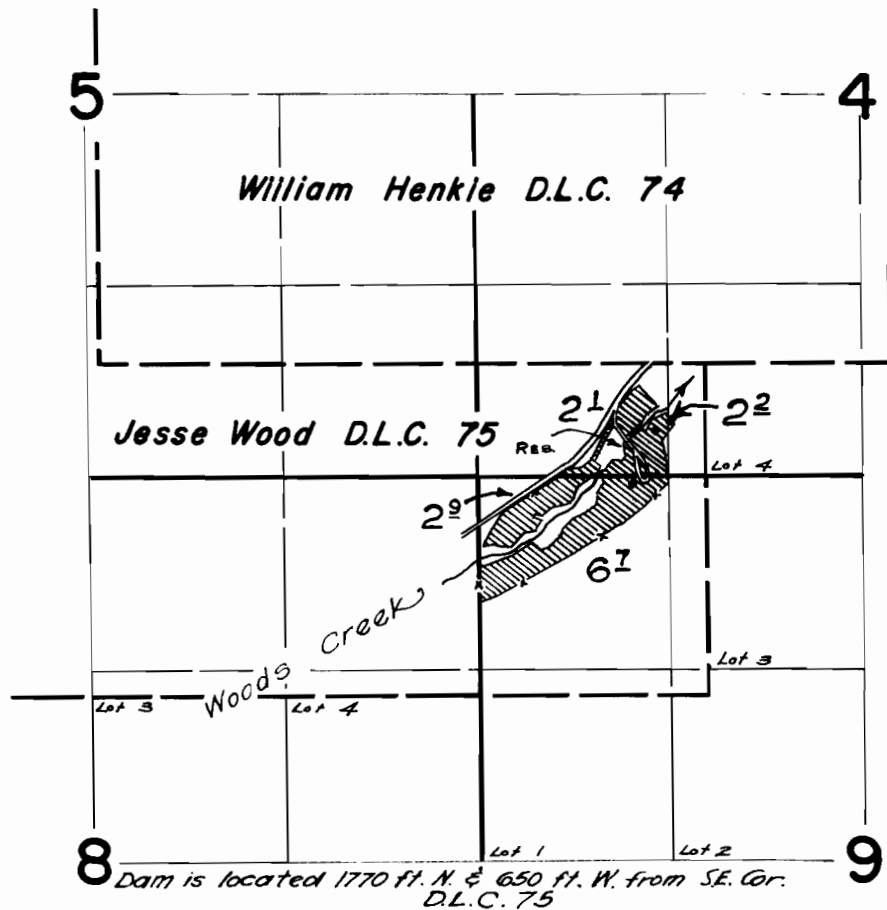

## FINAL PROOF SURVEY UNDER

R-37326 R-2722  
Application No. 37327 Permit No. 27809  
IN NAME OF

ROBERT E. KNIGHT

Surveyed Sept. 2 1965, by *St Jackson*