


To. T-4467

RECEIVED
MAR 24 1980
WATER RESOURCES DEPT
SALEM, OREGON

T 8S R 45E W.M.
SECTION 33

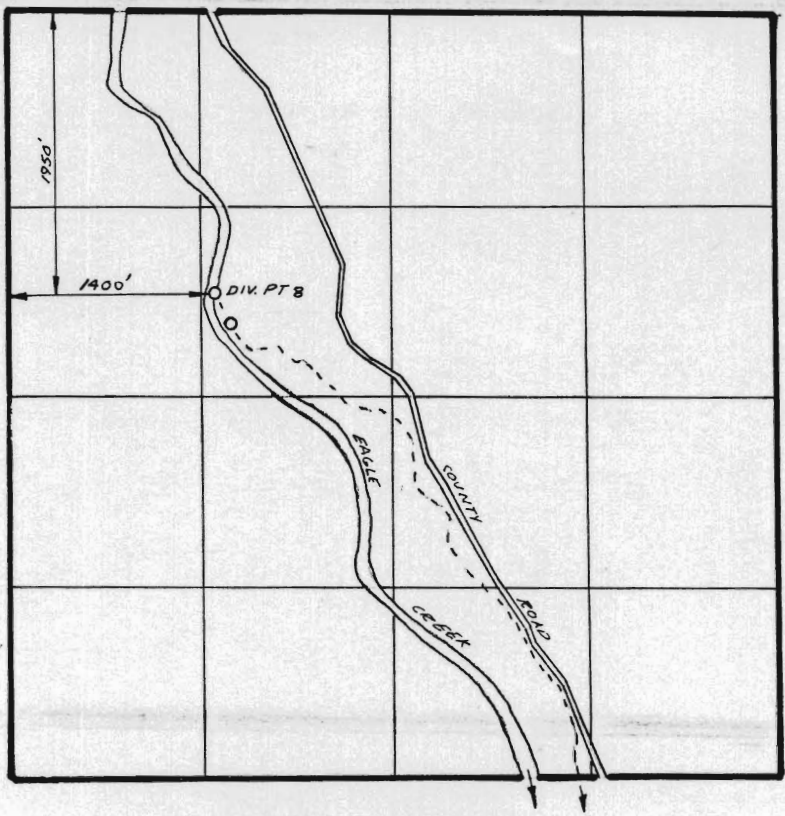

NEWT YOUNG DITCH