T.10 S. R. 2 W.W.M.

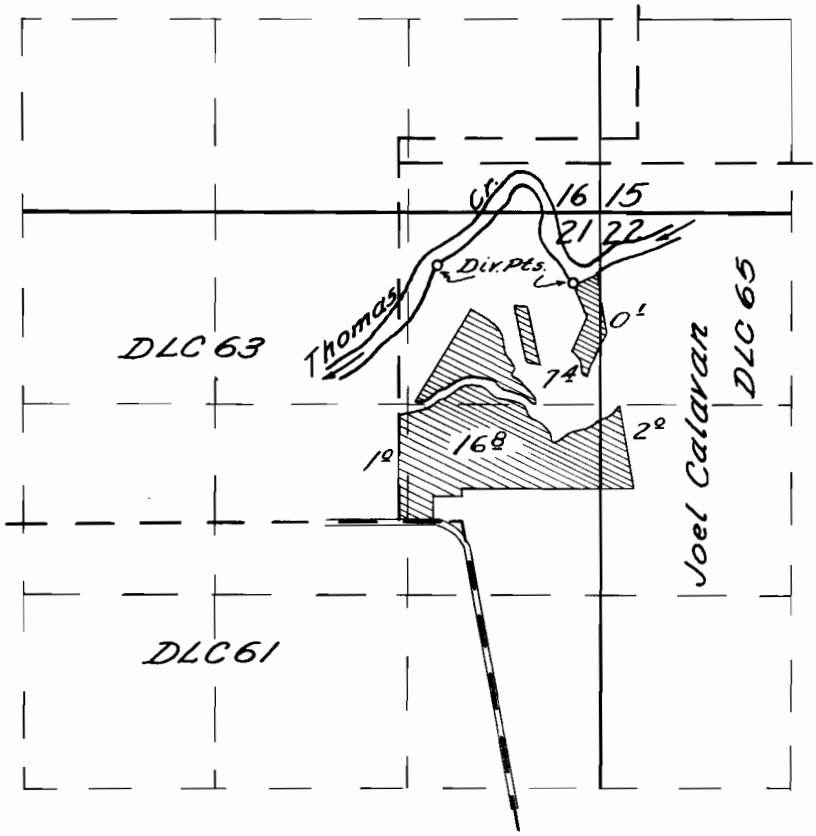

FINAL PROOF SURVEY

UNDER

Application No. 25648 Permit No. 20113

IN NAME OF

Walter R. & Anna M. Johnson

Surveyed July 25 1956, by R. H. Whitby

DFN-3D-206

CB.