



T. 10 S. R. 40 E. W.M.

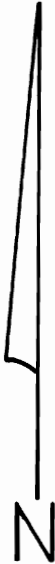

Scale 1"=1320'

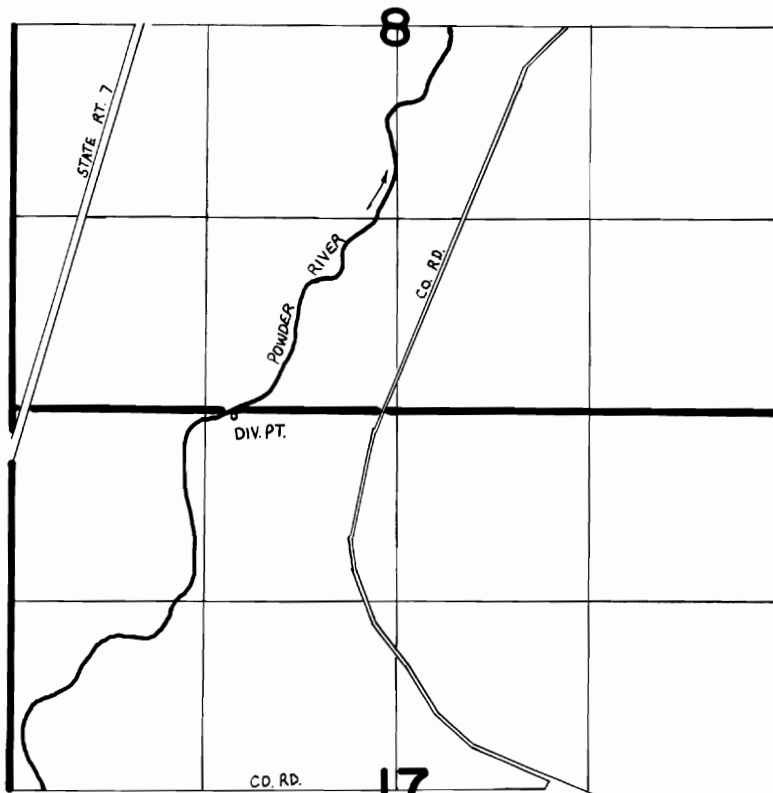

DIV. PT. LOC. 30' S. & 1530' E. FROM N.W. COR. SEC. 17

FINAL PROOF SURVEY UNDER TRANSFER 4480

IN NAME OF

.....**ROBERT McKITTRICK**.....

Surveyed June...2... 1986, by V. Church.....