


T. 13 S., R. 31 E., W.M.

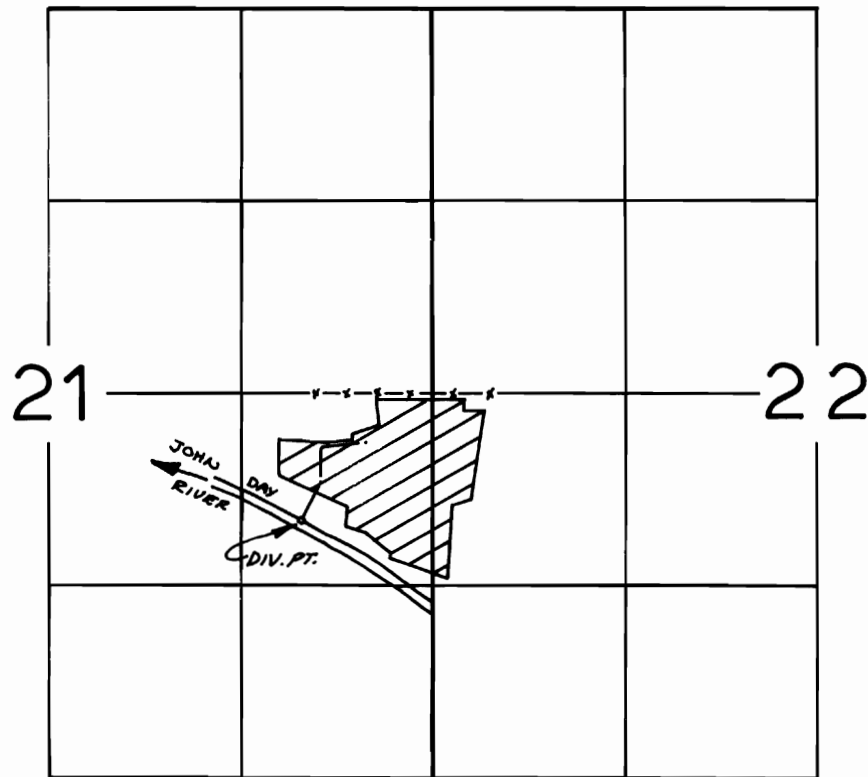

DIV. PT. LOC.: 870'S & 900'W FROM E $\frac{1}{4}$ COR. SEC. 21

FINAL PROOF SURVEY

UNDER

TRANSFER No. 4486

Application No. 59369 Permit No. 44679

IN NAME OF

JOHN DAY LUMBER CO.

Surveyed July 12, 1983, by R.W. CETTEL