


T. 39 S., R. 5 W., W. M.

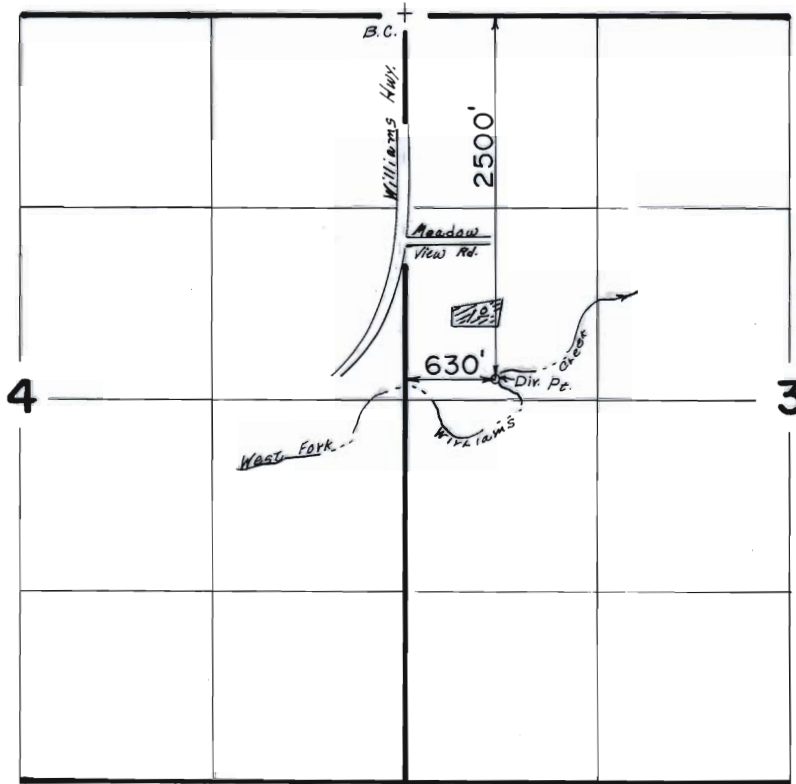

Scale: 1" = 1320'

FINAL PROOF SURVEY

UNDER

TRANSFER NO. 4488 & 5912

Application No. Permit No.

IN NAME OF

..... DAVID J. KUBOUSEK

Surveyed JUL. 13. 19.88, by B. S. JAMES....