


T.5S., R.4W., W.M.

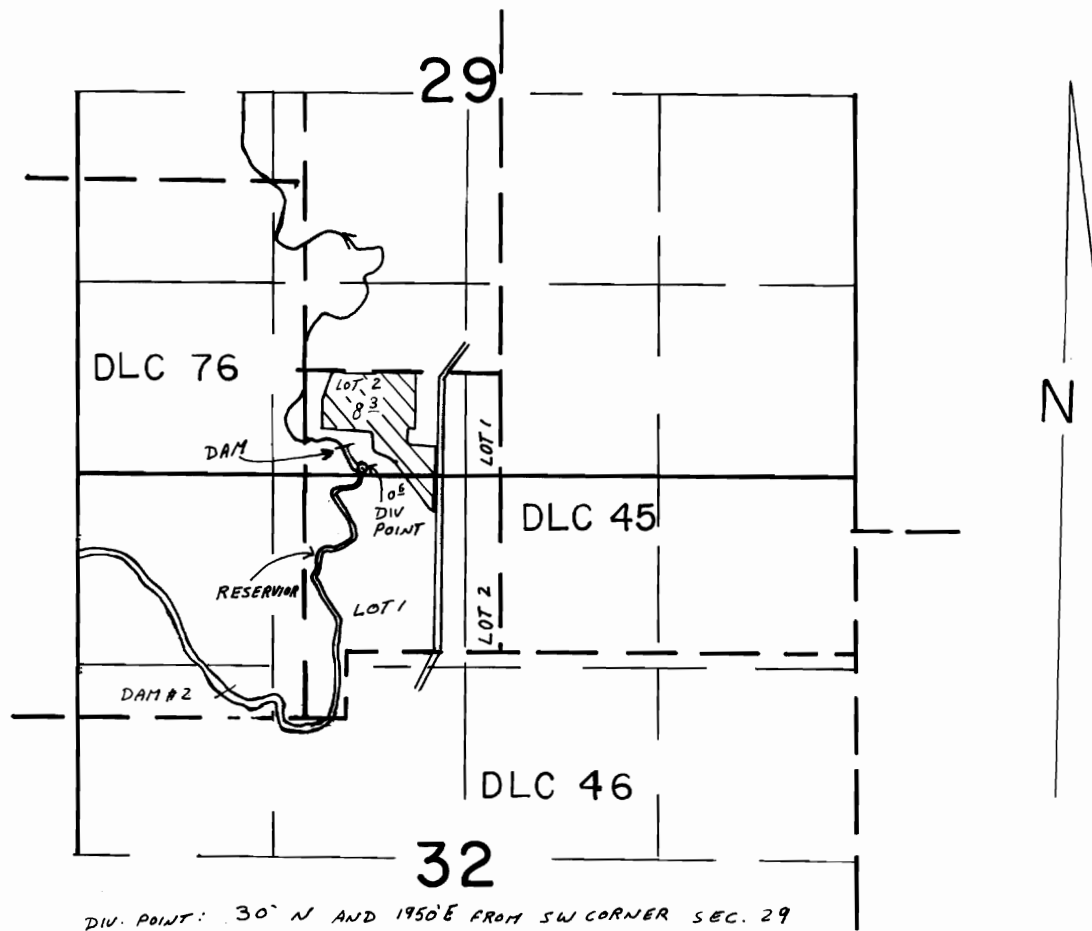

SCALE 1" = 1320'

FINAL PROOF SURVEY

UNDER

T-4492

R-60096

R-8208

Application No. 60097 Permit No. 45350

IN NAME OF

GAIL W. PRESSNAL

Surveyed AUG 29 1988 by Z. SALEH

4/071-178-71 D
8-29-88 Z.F.S.