


FTOM

T-4502

T 9S R 45E W.M.

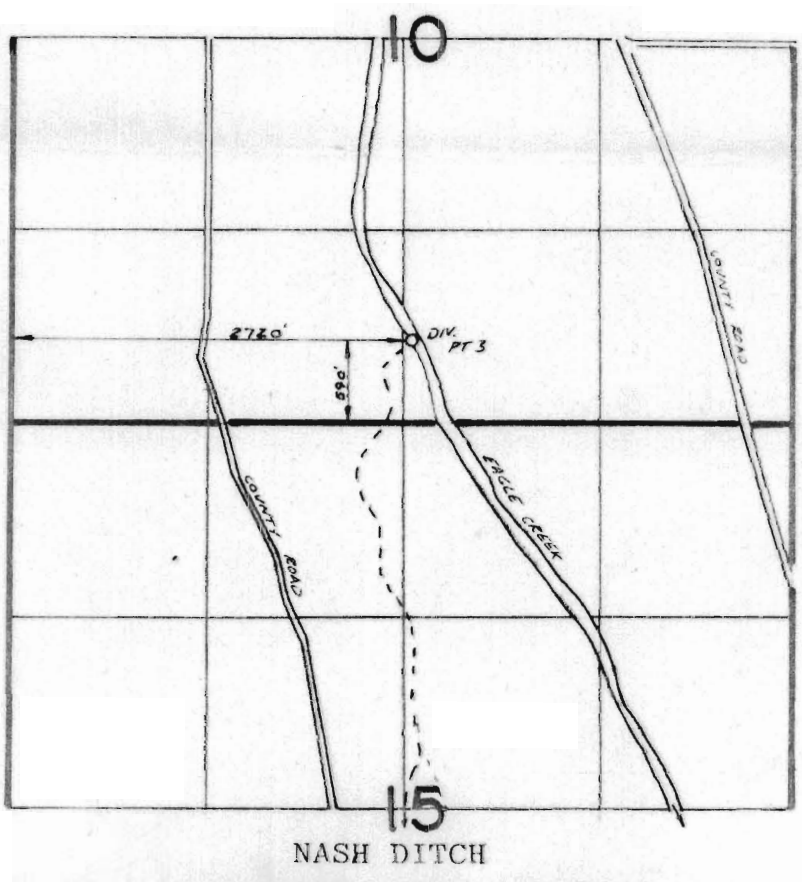

RECEIVED

MAY 13 1980

WATER RESOURCES DEPT  
SALEM, OREGON