


T. 6N., R. 35E., W.M.

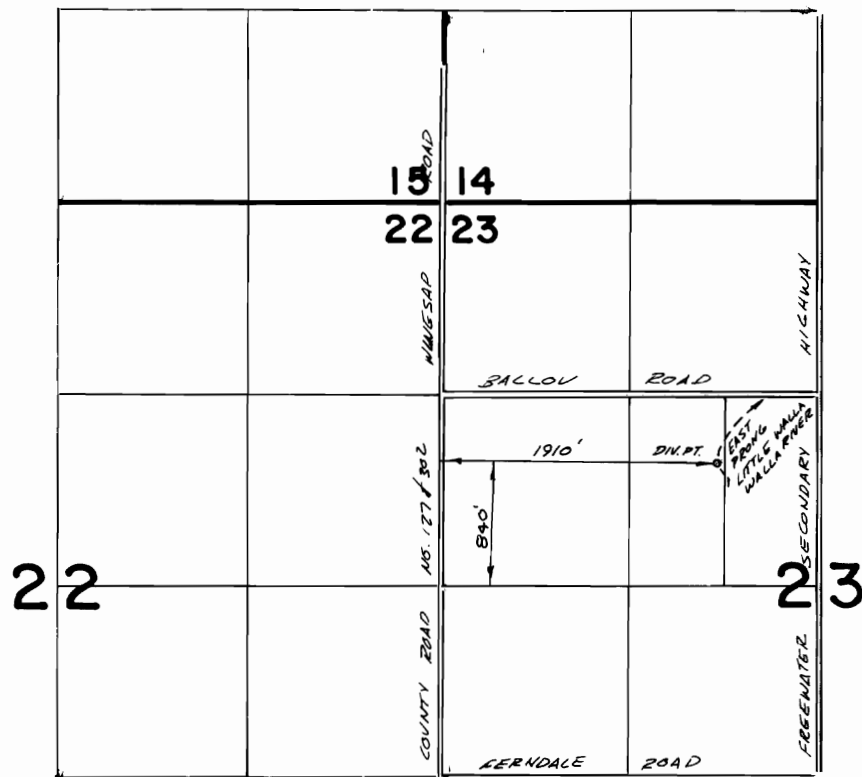

FINAL PROOF SURVEY
UNDER

TRANSFER 4509

IN NAME OF

.....**ELDIN W. & LORRAINE REED**.....

Surveyed 8-26-1981, by *Kenon Lee Church*