



RECEIVED  
MAY 20 1980  
WATER RESOURCES DEPT  
SALEM, OREGON

T 38 S, R 19 E, W.M.

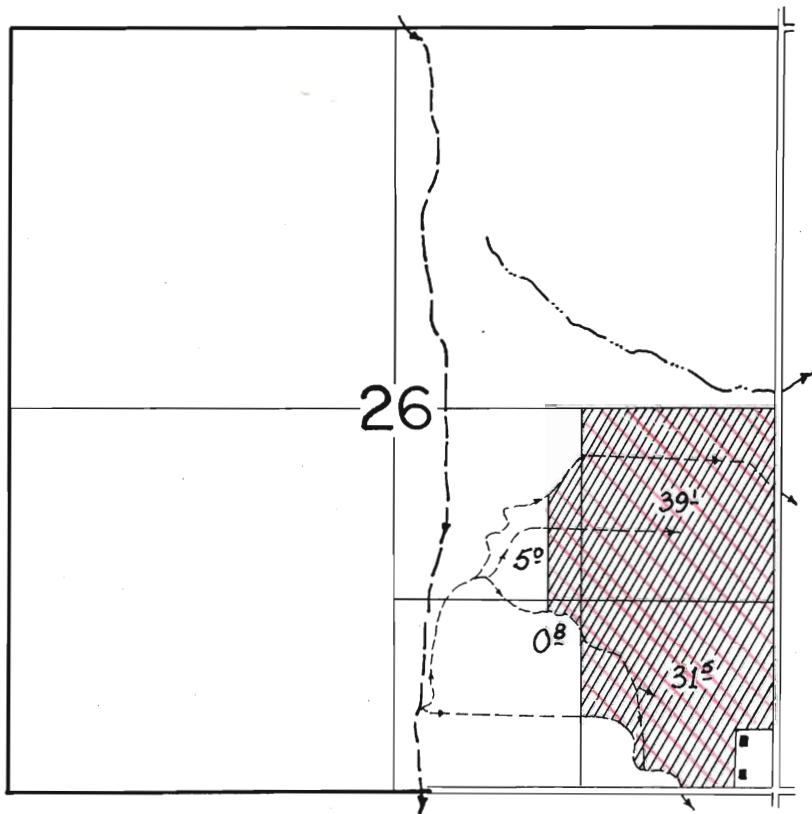

 Transfer from, To SEC 25, T38S, R19E W.M.

7388, RISE, N.M.

