


W.M.

T-4515

RECEIVED

MAY 21 1980

WATER RESOURCES DEPT
SALEM, OREGON

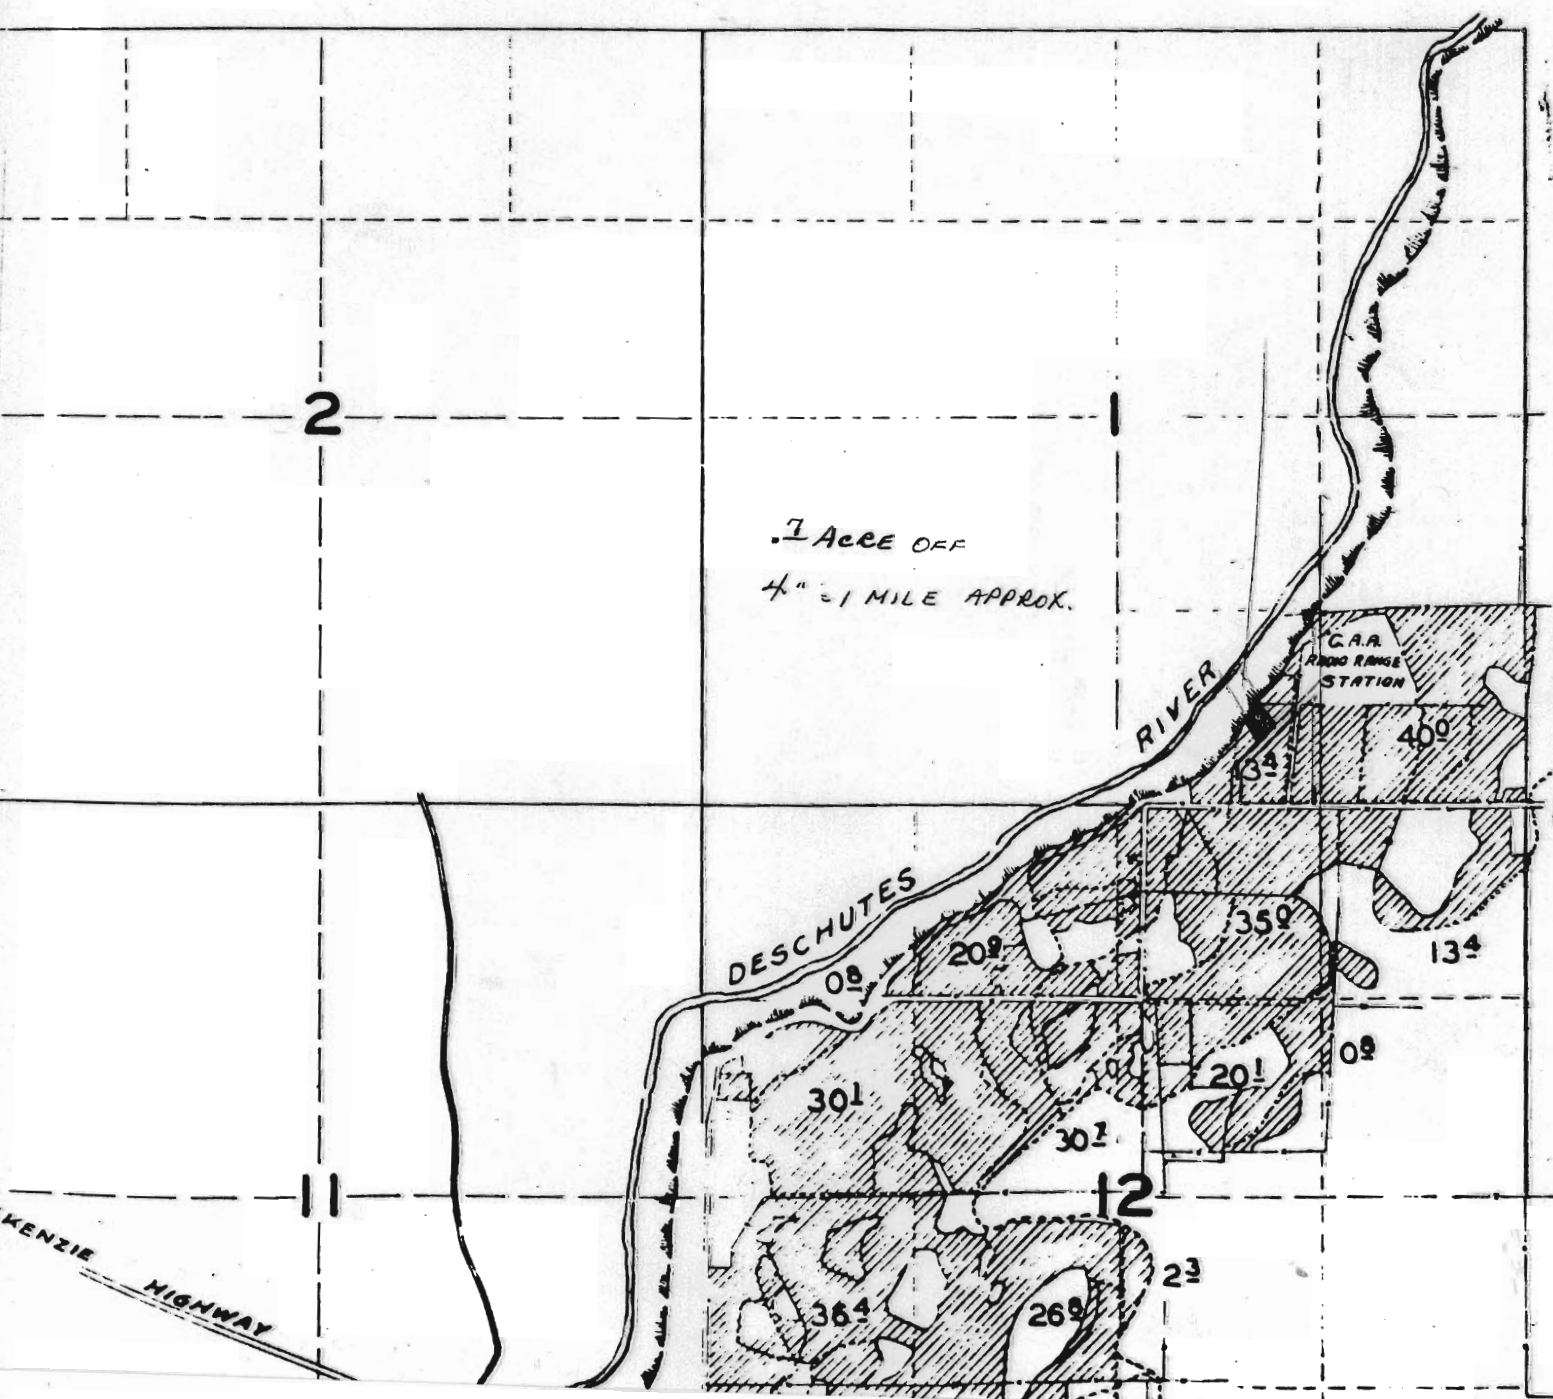

1470 T-4515

