


T.39S., R.3W., W.M.

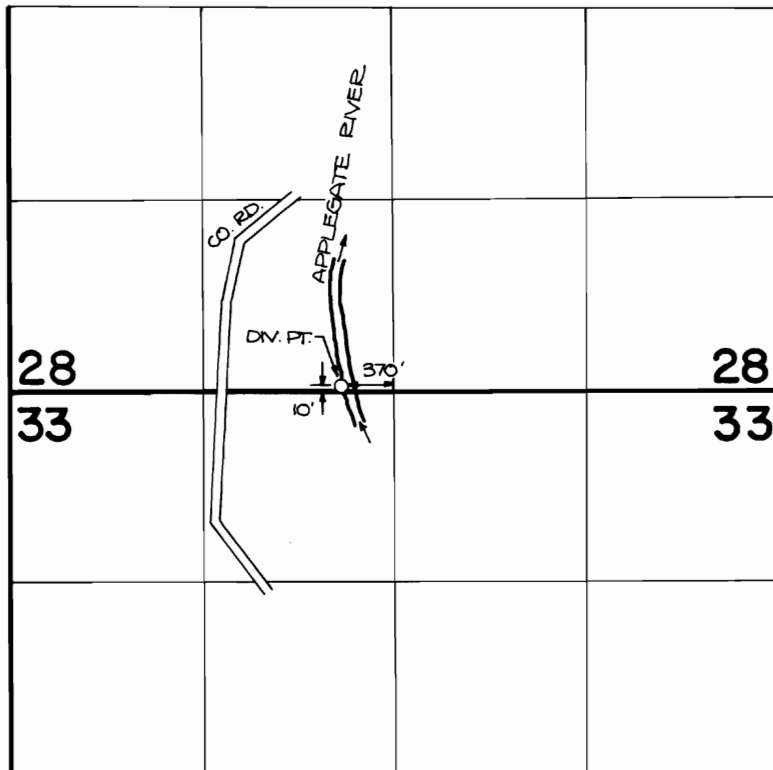

FINAL PROOF SURVEY
UNDER

TRANSFER NO. 4519

IN NAME OF

HIROSHI WALTER EMORI & HIROMU MORIKONE

Surveyed **MAY 19 1983**, by **B. JAMES**