


T.13S.,R.31E.,W.M.

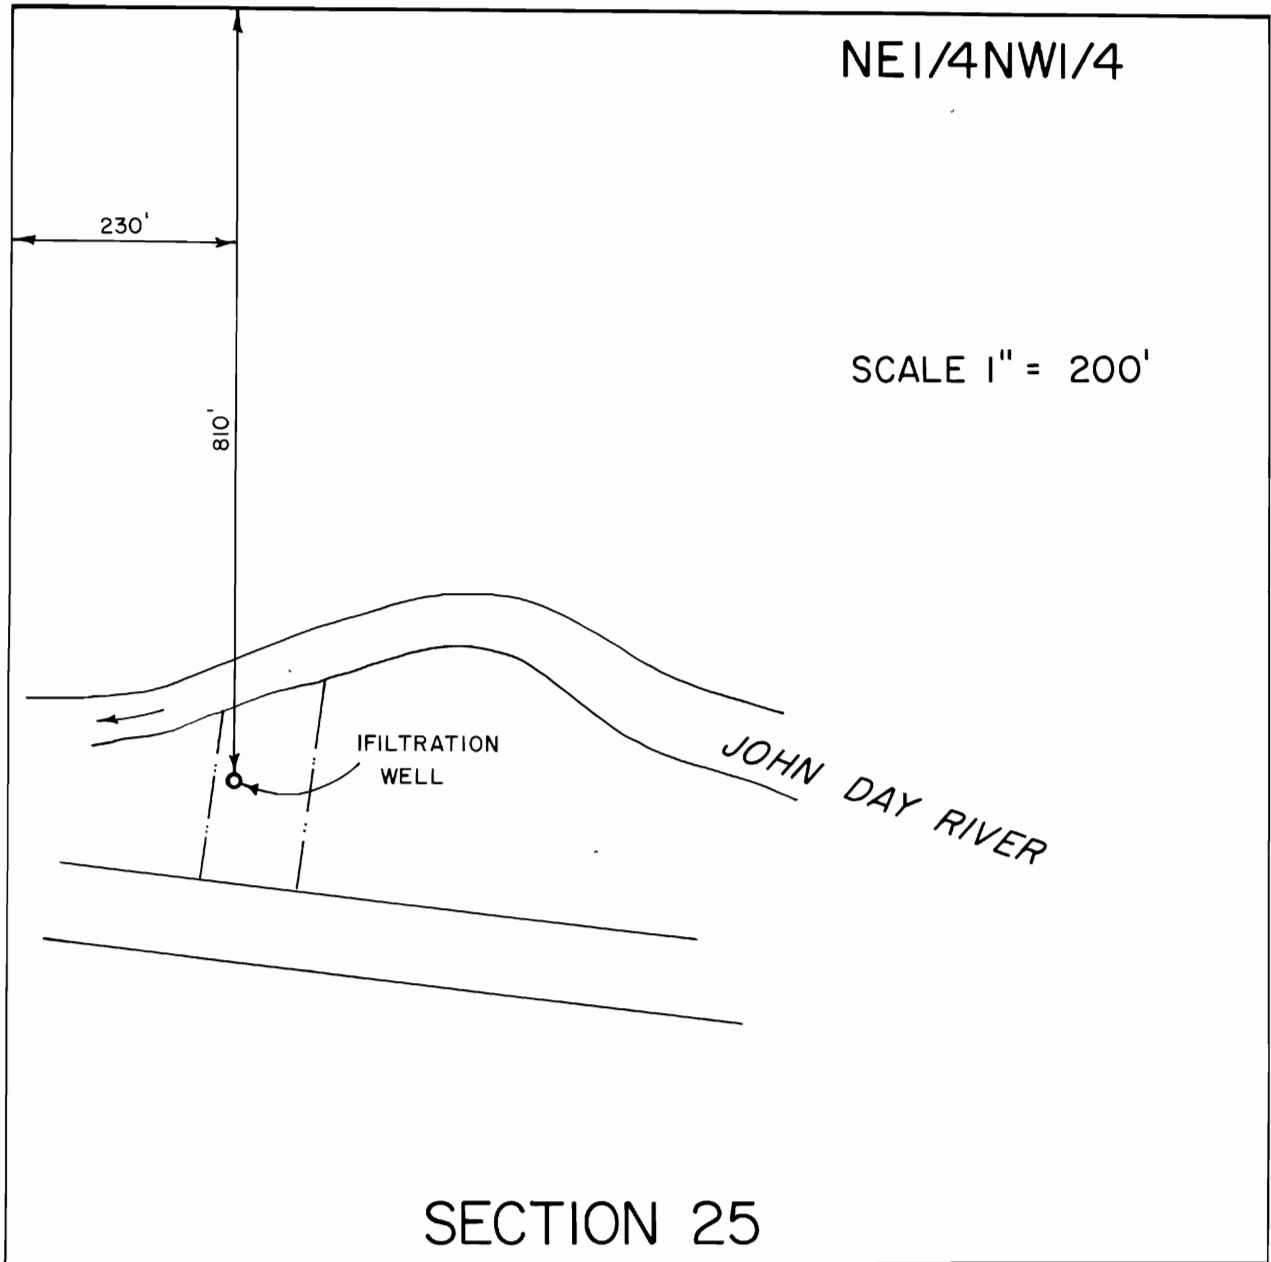

FINAL PROOF SURVEY UNDER

TRANSFER NO. 4536

IN NAME OF

JACK & ELAINE KIGHT

Surveyed AUG. 27, 1981, by *dBrown*