


T. 35 S., R. 1 W., W.M.

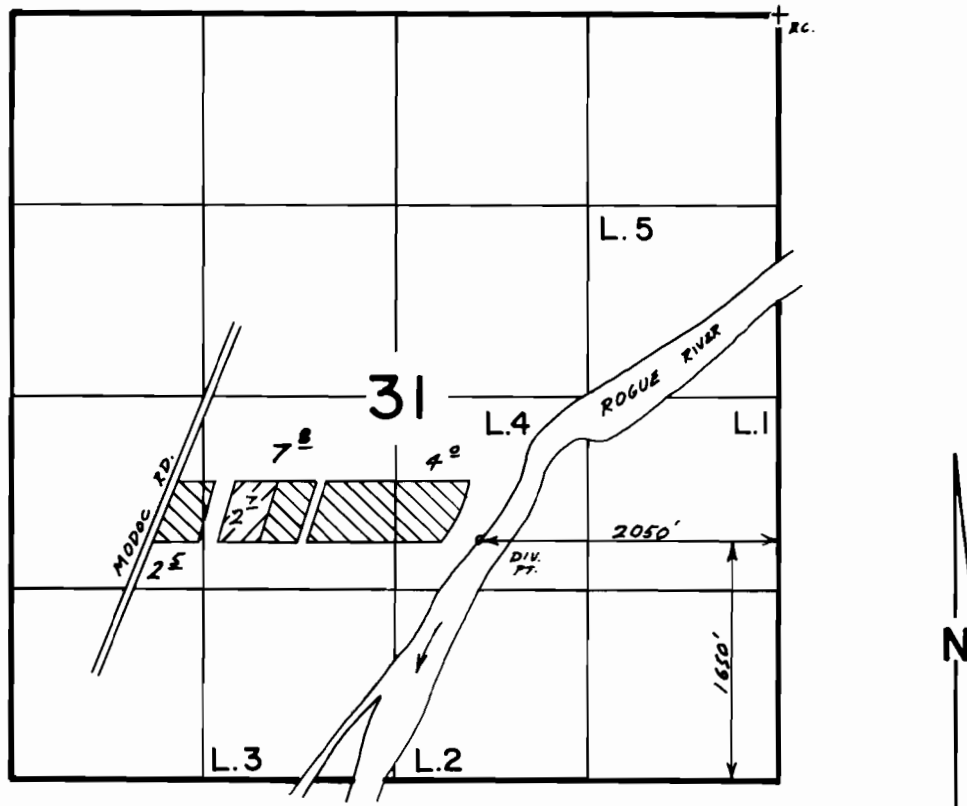

Scale 1" = 1320'

FINAL PROOF SURVEY
UNDER

☒ TRANSFER

☒ PERMIT

Transfer No. 4552

Application No. 60303 Permit No. 45006
IN NAME OF

JIMMIE D. & PHILLIS WRAY

Surveyed MAY 14, 1987, by B.S. JAMES