


T. 34 & 35 S., R. 3 W., W. M.

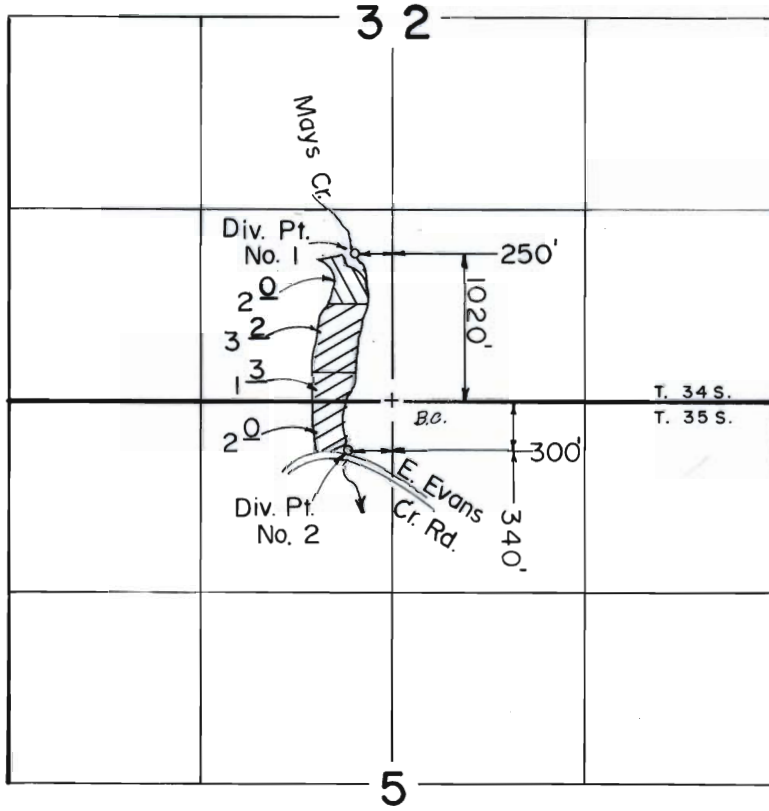

Scale:
1" = 1320'

FINAL PROOF SURVEY

UNDER

TRANSFER NO. 4559

TRANSFER NO. 4560

Application No. Permit No.

IN NAME OF

DONALD R. &/OR JO ANNE M. HEWITT

Surveyed JUN. 4. 1987., by B. S. JAMES....