


T13 & 14S. R7W. WM.

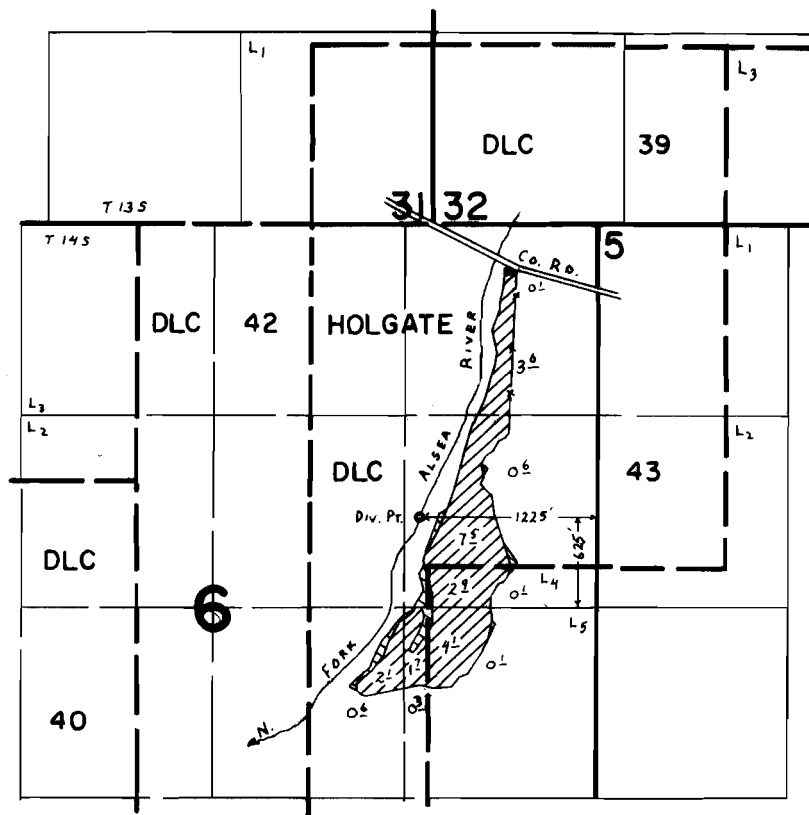

FINAL PROOF SURVEY UNDER

Transfer No. T-3352
 Application No. 53720 Permit No. 40343
 IN NAME OF

ELIZABETH BOND STARKER

Surveyed Aug. 16, 1979, by C. L. HUGHES