


T. 36 S., R. 5 W., W.M.

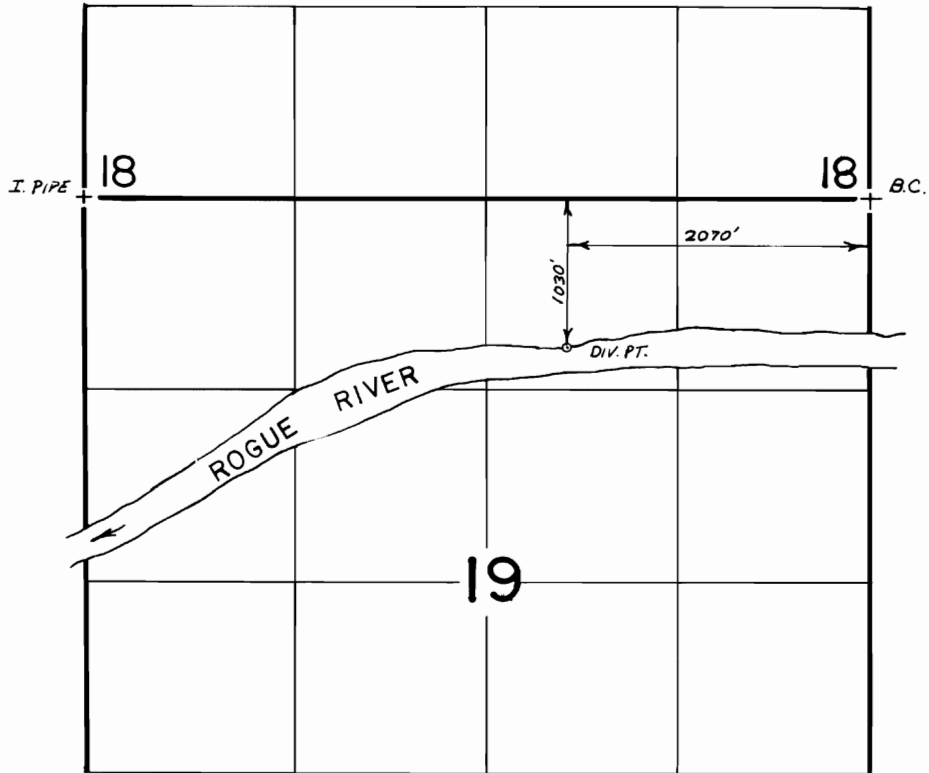

Scale 4" = 1 mile

**FINAL PROOF SURVEY**  
UNDER

Transfer No. 4564

Application No. .... Permit No. ....

IN NAME OF

..... **MARION WALSER** .....

Surveyed Oct. 21, 1981, by Bruce R. Sund..