


T.4S. R.4W. W.M.

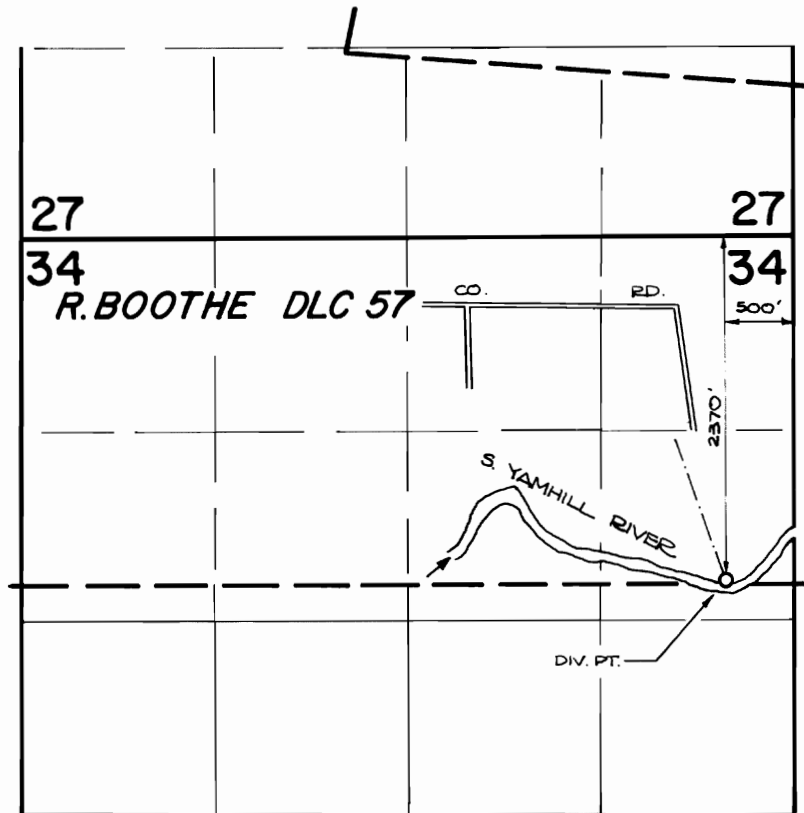

FINAL PROOF SURVEY
UNDER

TRANSFER NO. 4566

IN NAME OF

SOL J. YUTZY

Surveyed **SEPT. 30, 1983**, by *P. Paster*