


T. 39 S., R. 5 W., W. M.

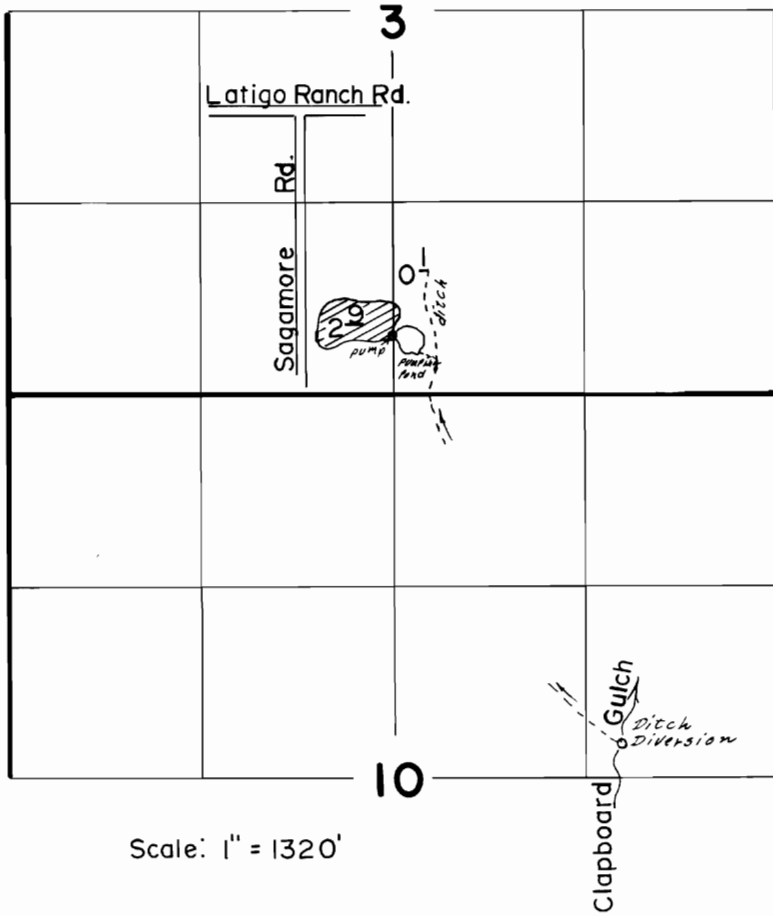

Scale: 1" = 1320'

FINAL PROOF SURVEY UNDER

TRANSFER NO. 4575

Application No. Permit No.
IN NAME OF

BRONELLE W. & VELMA M. GREER

Surveyed JUL 13 1988, by B. S. JAMES