


T. 9S., R. 45E., W.M.

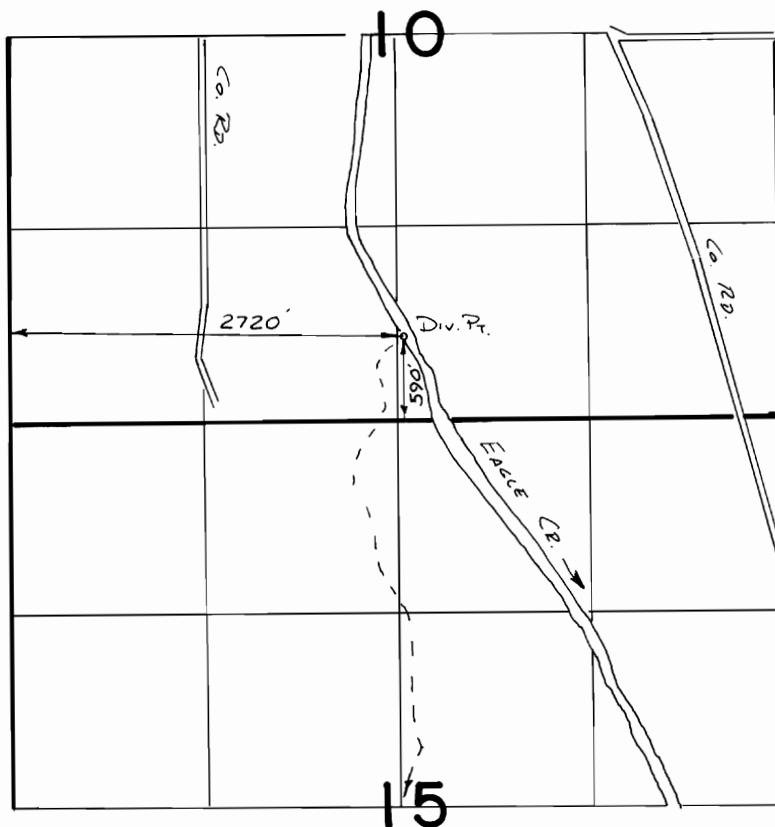

SCALE 1" = 1320

**FINAL PROOF SURVEY**  
UNDER

**TRANSFER 4576**  
IN NAME OF

.....**DAN L. FORSEA & SONS**.....

Surveyed *Nov. 18* 19*86*, by *V. L. Church*