


# T.13&14S.,R.32E.,W.M.

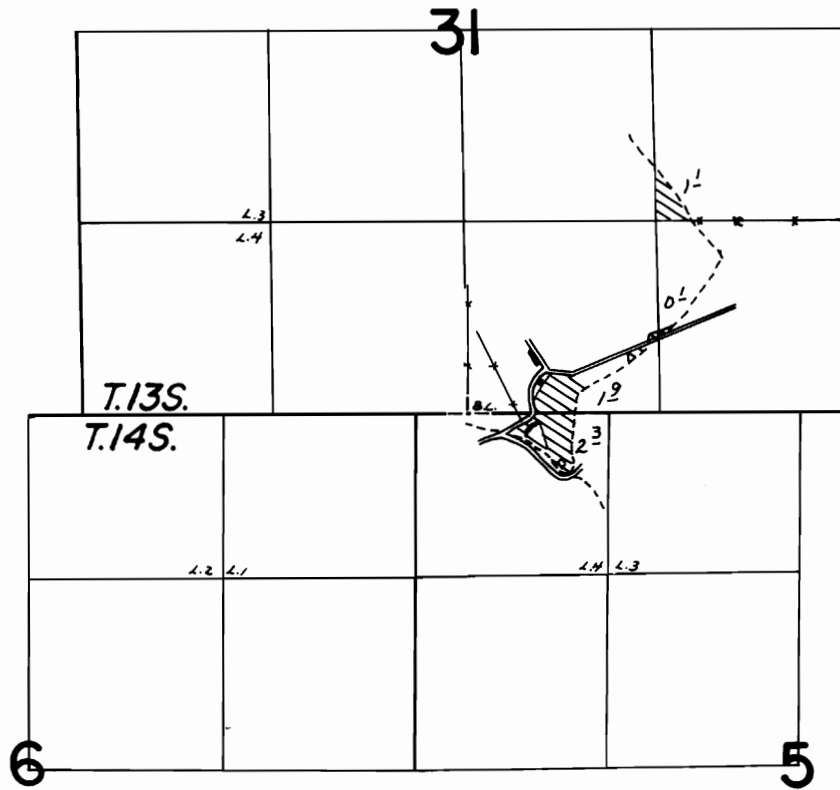

## FINAL PROOF SURVEY UNDER

Transfer No. 4577  
Application No. .... Permit No. ....  
IN NAME OF

CARL & BETTY JANE SHEEDY

Surveyed July...7... 19.83., by R.W. Cattel.....