


T. 30S., R. 4W., W.M.

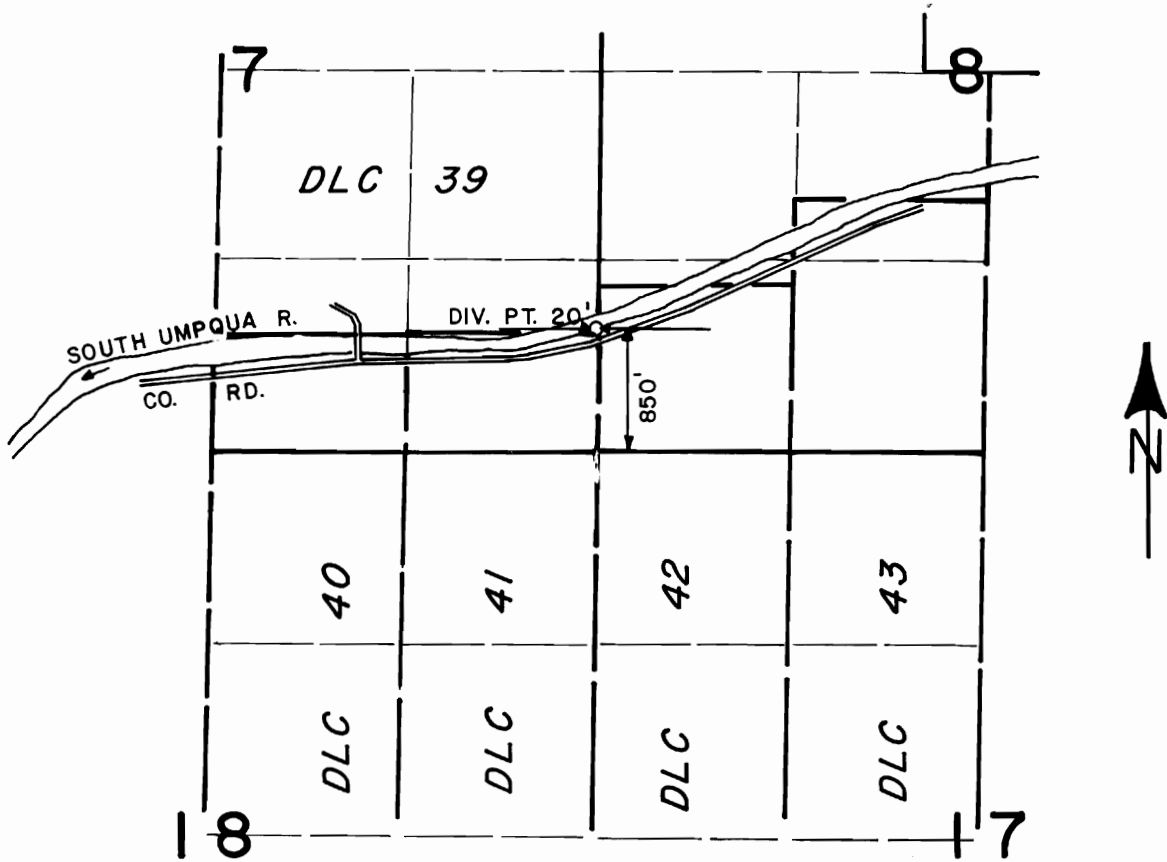

SCALE: 4" = 1 MILE

FINAL PROOF SURVEY
UNDER

TRANSFER NUMBER 4580

IN NAME OF

HAYDEN L. & ROI JEAN LAURANCE

Surveyed JUNE 24, 1986., by J.M. SCHMORDE.