


T-4592

RECEIVED

AUG 29 1980

WATER RESOURCES DEPT
SALEM, OREGON

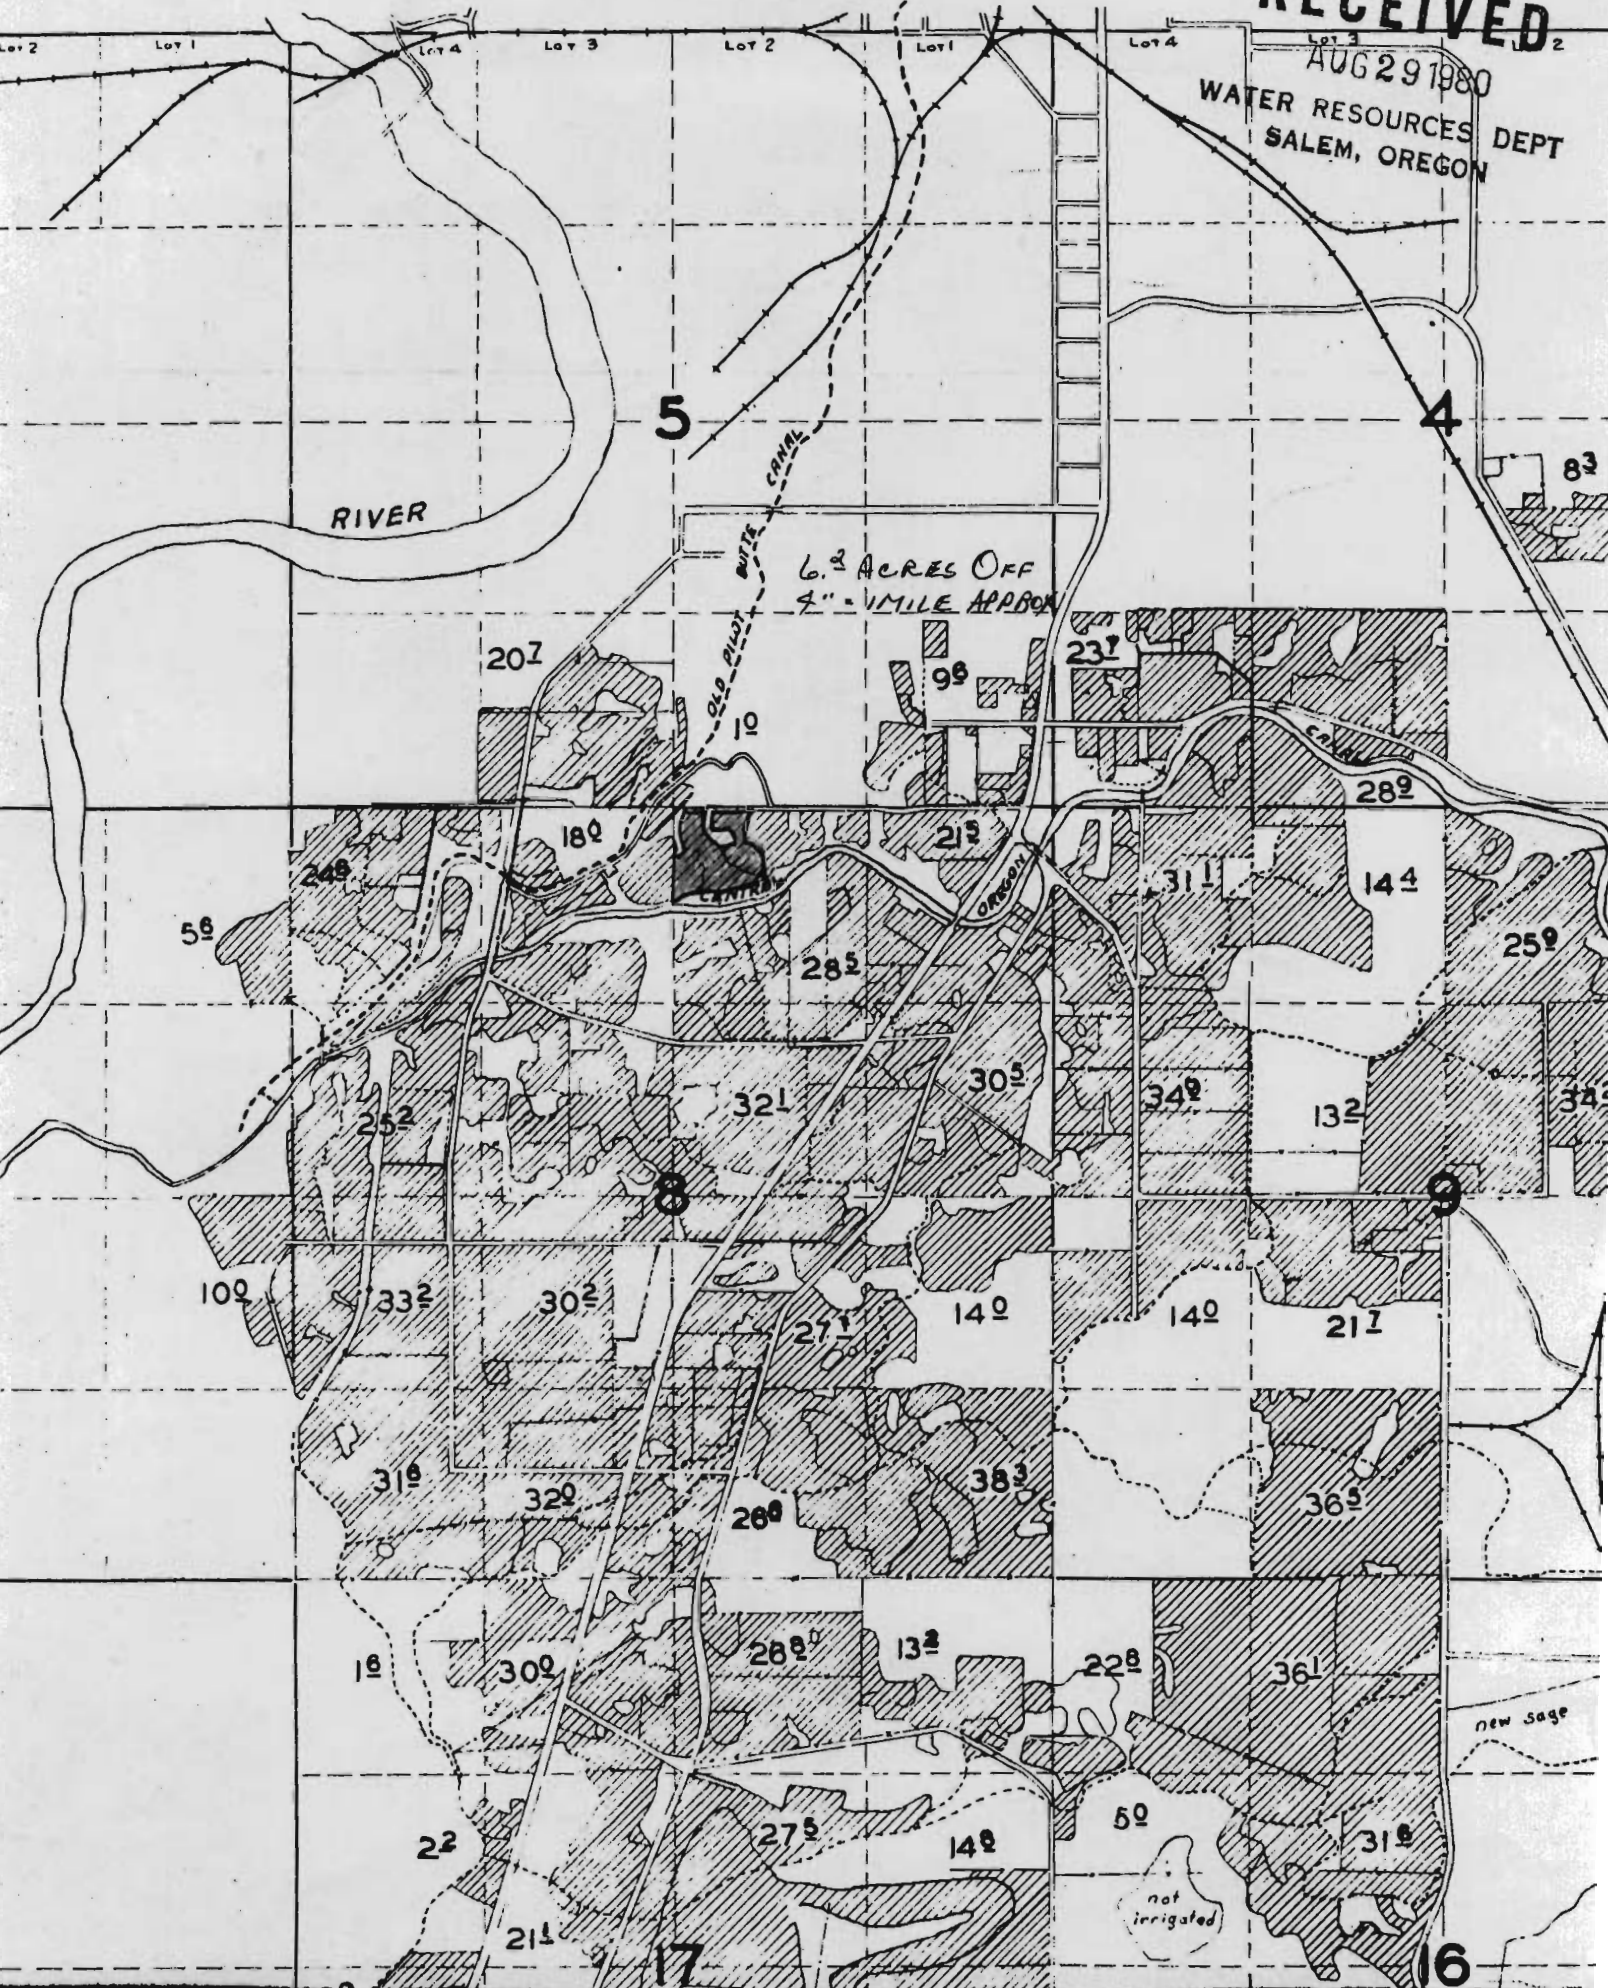

5

4

RIVER

OLD PILOT BUTTE CANAL

6.2 ACRES OFF

207

98

231

56

249

180

282

219

289

259

252

321

302

349

132

349

100

332

302

271

140

140

211

319

320

269

383

369

18

309

289

132

228

361

22

275

149

50

319

211

17

16


not irrigated

new sage




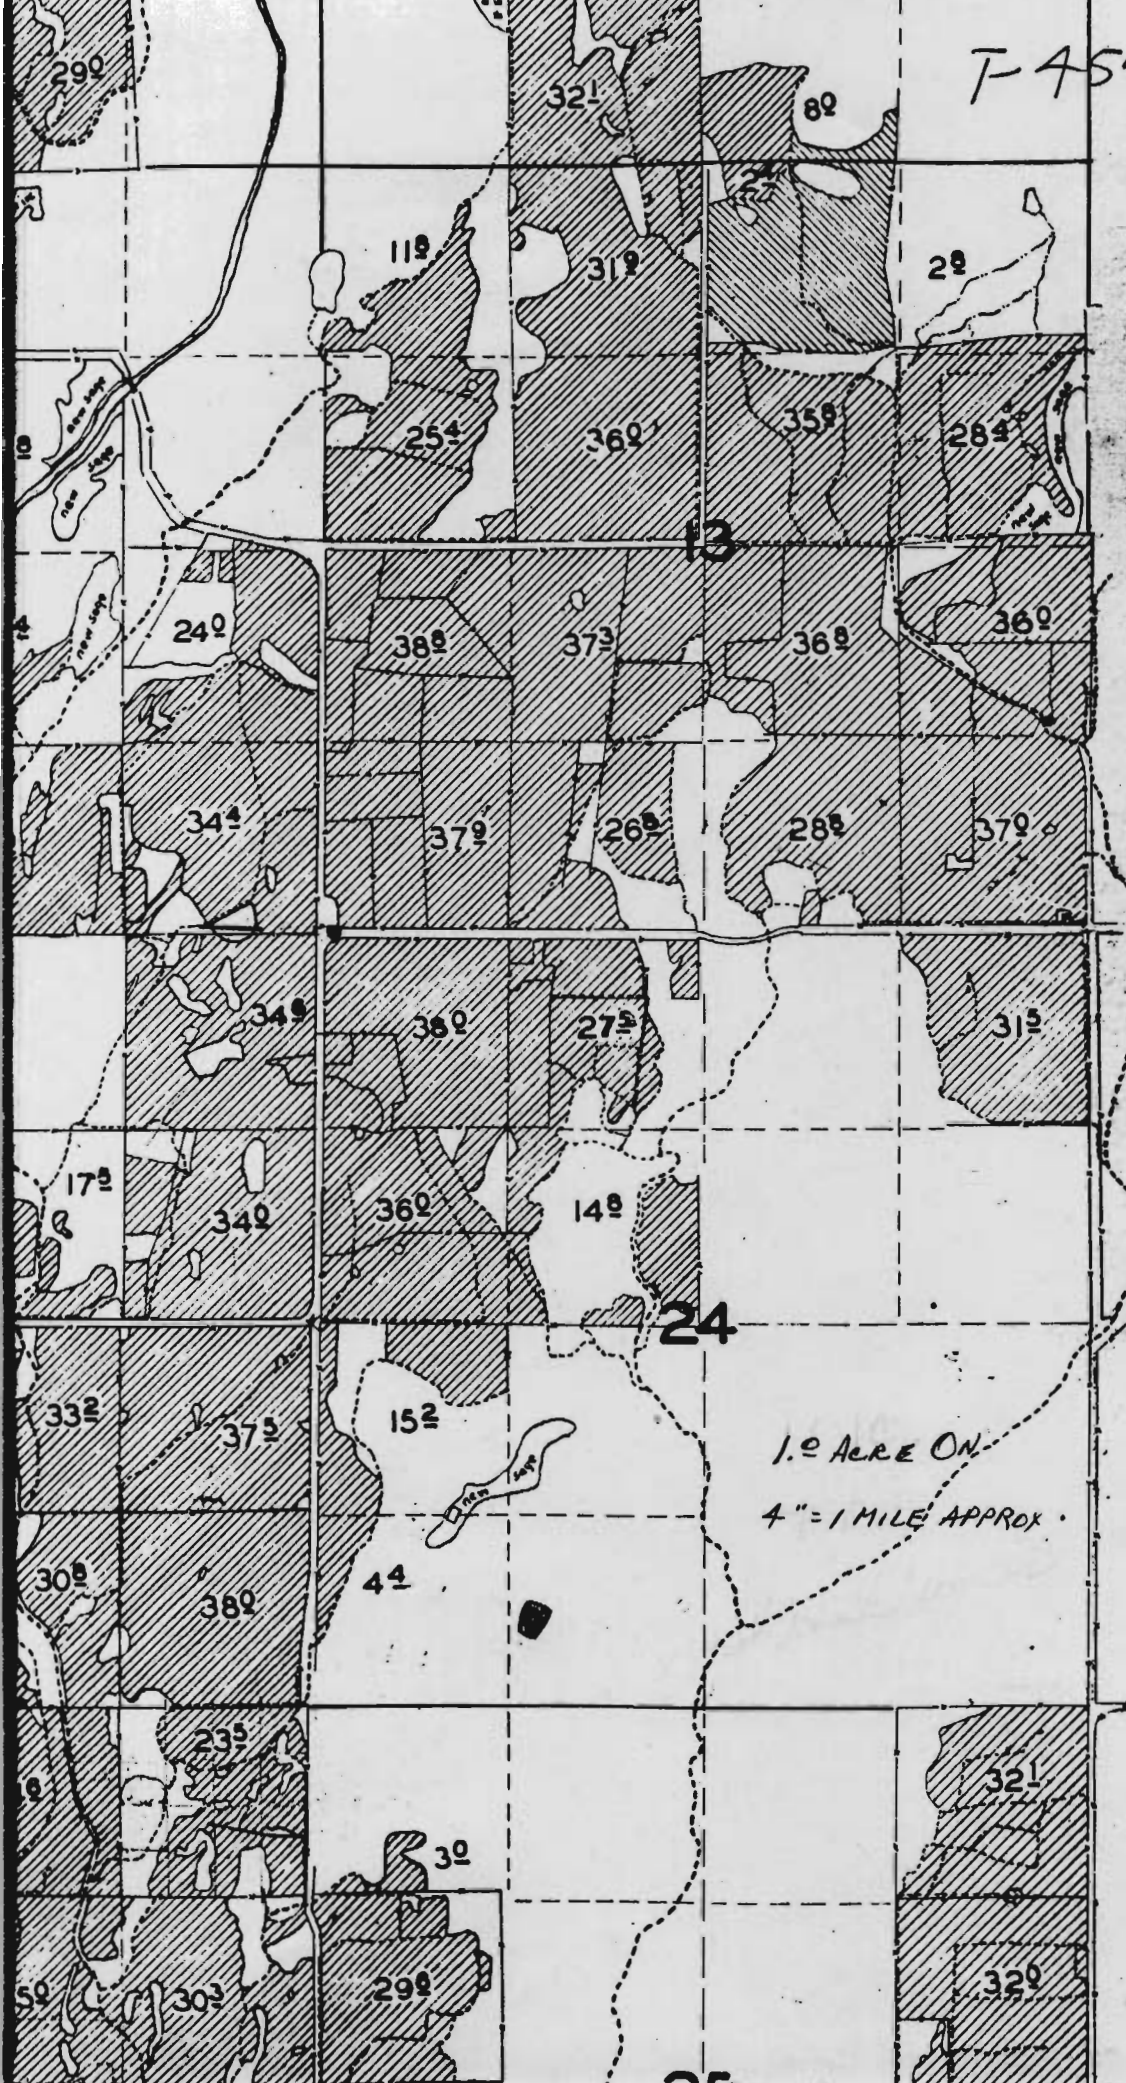

1.0 ACRE ON
4" = 1 MILE APPROX.

T-4592

RECEIVED

AUG 29 1980

WATER RESOURCES DEPT
SALEM, OREGON

TOTAL -

5.2 ACRES ON

4" = 1 MILE APPROX

