


T. 25 S. , R. 7 W. , W. M.

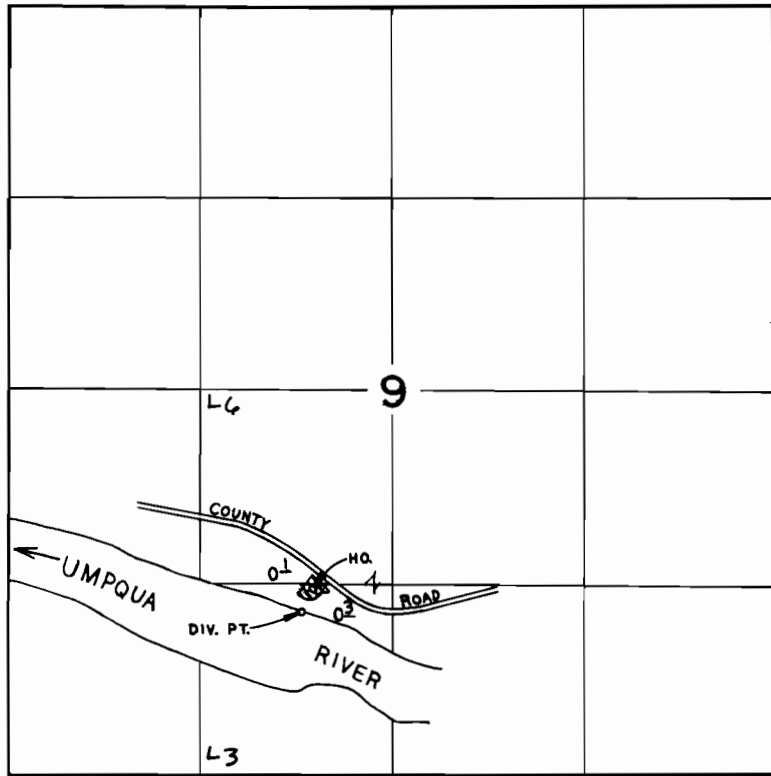

DIV. PT. LOCATED 1,525' S. & 2,010' E. FROM W. 1/4 COR. SEC. 9

SCALE: 4" = 1 mile

FINAL PROOF SURVEY UNDER

T-4604

Application No. 60901... Permit No. 45395.....

IN NAME OF

.....WILLIAM H. HUTTON.....

Surveyed FEB. 27, 1985, by L. CASHION...