


T. 13 S. R. 27 & 28 E., W.M.

TRANSFER APPLICATION MAP FOR PAUL & EVELYN LEVATIN

RECEIVED

SEP 22 1980

WATER RESOURCES DEPT
SALEM, OREGON

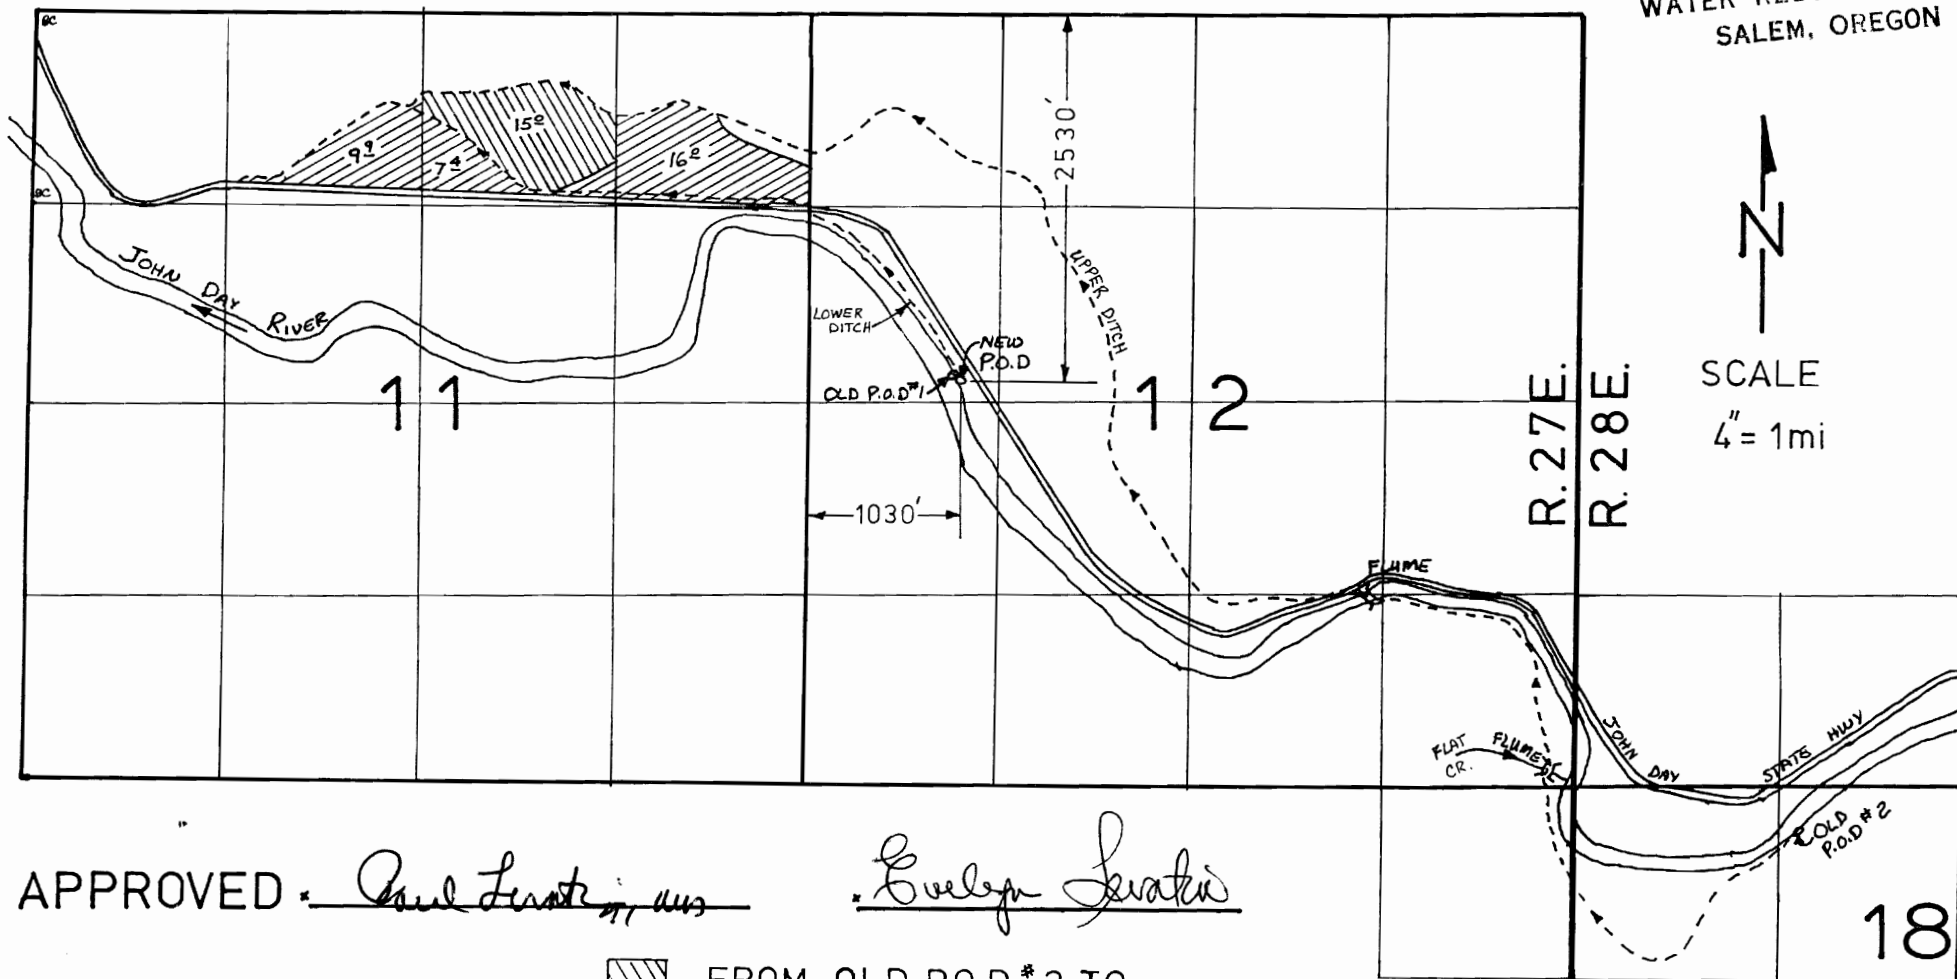

APPROVED: Paul Levatin

Evelyn Levatin

 FROM OLD P.O.D.# 2 TO NEW P.O.D.

 FROM OLD P.O.D.# 1 TO NEW P.O.D.

THIS MAP PREPARED BY:
RWCETTEL 9-15-80

FROM INFORMATION FURNISHED BY
THE APPLICANT

18