
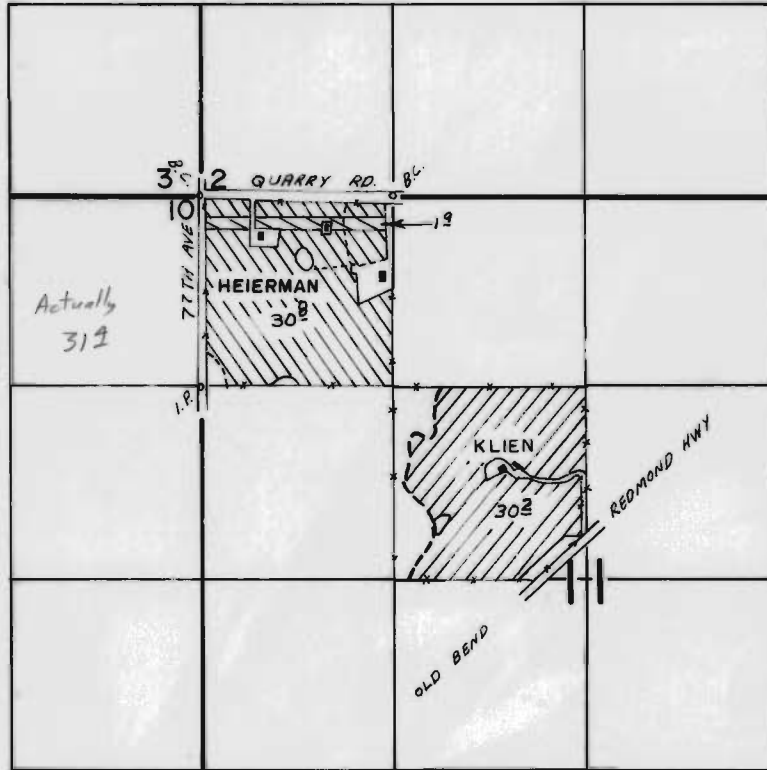
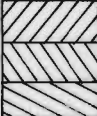



T.16S. R.12E. W.M.

 

 KLEIN PORTION C-170
 HEIERMAN PORTION C-170
 3463

FINAL PROOF SURVEY
UNDER

TRANSFER NO. C-170
3463

Application No. Permit No.
IN NAME OF

....DAN..H..HEJERMAN, SR. & ORVAL..KLEIN...

Surveyed APR.4,8.. 1980., by L.H..NUNN.....