


T.18S. R.12E. W.M.

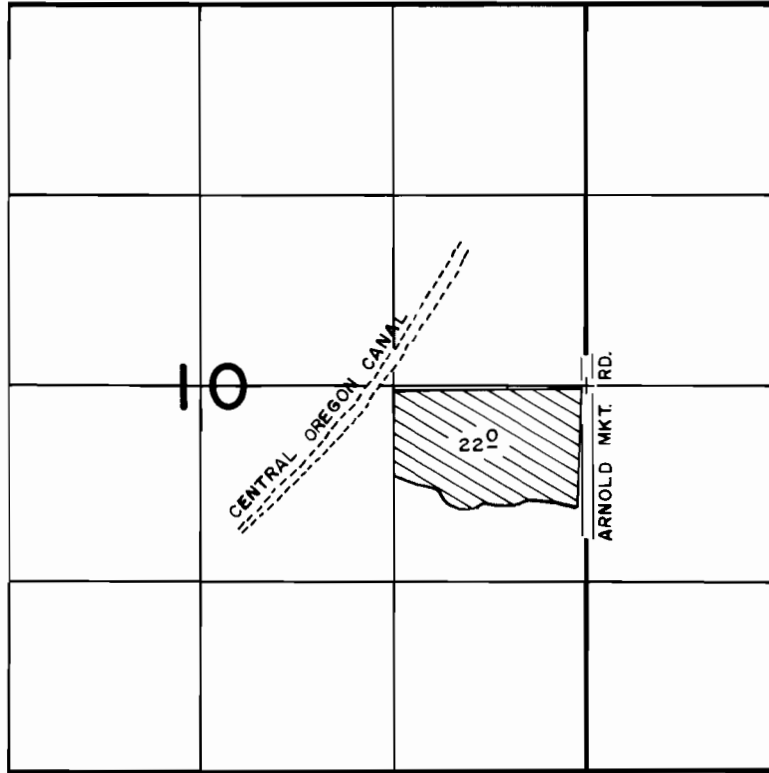

FINAL PROOF SURVEY
UNDER

TRANSFER NO. 2524

Application No. Permit No.

IN NAME OF

..... **DAVID GARCIA**

Surveyed DEC. 1, 23. 1980., by L.H. NUNN.....